USE TYPEWRITER OR BALL POINT PEN-PRESS FIRMLY, PRINT CLEARLY.

WATER WELL RECORD
KSA 82a-1201-1215

cba

Kansas Department of Health and Environment-Division of Environment
(Water well Contractors)
Topeka, Kansas 66620

1. Location of well:	County	Fraction	Section number	Township number	Range number
	Jefferson	NE 1/4 NW 1/4 SW 1/4	16	T 11S S	R 18E (E) W

2. Distance and direction from nearest town or city: 2mi. west of Perry, Ks. on U.S.24, ½ mi. N. & ¼ mi. East.
Street address of well location if in city:

3. Owner of well: Dale Hupe
R.R. or street:
City, state, zip code: Perry, Kansas 66073

4. Locate with "X" in section below:

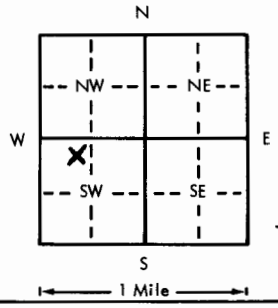

Sketch map:

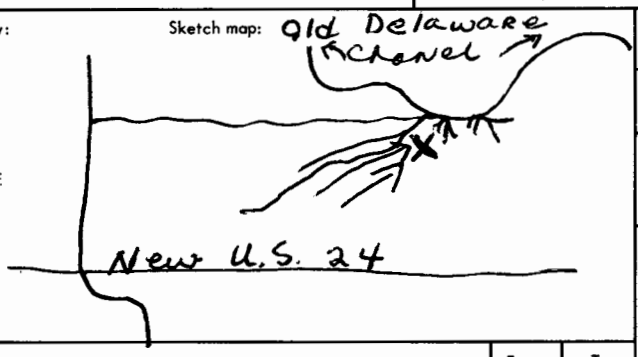

6. Bore hole dia. 30 in. Completion date 12-18-77
Well depth 88 ft.

7. __ Cable tool __ Rotary __ Driven __ Dug
__ Hollow rod __ Jetted __ Bored X Reverse rotary

8. Use: __ Domestic __ Public supply __ Industry
X Irrigation __ Air conditioning __ Stock
__ Lawn __ Oil field water __ Other

9. Casing: Material Trans. Height: Above or below
Threaded ___ Welded ___ Surface 12" in.
RMP ___ PVC ___ Weight ___ lbs./ft.
Dia. 16 in. to 62 ft. depth Wall Thickness: inches or
Dia. ___ in. to ___ ft. depth gage No. .75"

5. Type and color of material	From	To
Hard black silt	0	3
Hard brown silt	3	27
Gray clay	27	31
Fine to small gray gravel	31	38
Small to med. gray gravel & gray clay	38	40
Med. gray gravel	40	56
Med. dark brown gravel	56	68
Med. to large dark brown gravel	68	88
Hard green till-stopped.	88	
(Use a second sheet if needed)		

10. Screen: Manufacturer's name Johnson Well Casing Co.
Type transite Dia. 16"
Slot/gauze 1/8 x 8 Length 26'
Set between 62 ft. and 88 ft.
___ ft. and ___ ft.
Gravel pack? yes Size range of material 5/8

11. Static water level: mo./day/yr.
12 ft. below land surface Date 12-18-77

12. Pumping level below land surfaces:
15 ft. after 1 hrs. pumping 1000 g.p.m.
22 ft. after 3 hrs. pumping 1500 g.p.m.
Estimated maximum yield 2000 g.p.m.

13. Water sample submitted: mo./day/yr.
__ Yes X No Date

14. Well head completion:
__ Pitless adapter ___ Inches above grade

15. Well grouted? yes
With: __ Neat cement __ Bentonite X Concrete
Depth: From 0 ft. to 10 ft.

16. Nearest source of possible contamination:
ft. 100 Direction north Type old chanel
Well disinfected upon completion? ___ Yes X No

17. Pump: X Not installed
Manufacturer's name
Model number ___ HP ___ Volts ___
Length of drop pipe ___ ft. capacity ___ g.p.m.
Type:
__ Submersible __ Turbine
__ Jet __ Reciprocating
__ Centrifugal __ Other

18. Elevation: 950 Km
Topography:
__ Hill
__ Slope
__ Upland
X Valley

19. Remarks:

20. Water well contractor's certification:
This well was drilled under my jurisdiction and this report is true to the best of my knowledge and belief.
Hoobler Drilling Co. 323
Business name License No.
Address St. Marys, Ks. 66536
Signed [signature] Date 1-5-78
Authorized representative

T 11 R 18 W Sec 16 1/4 NE 1/4 NW 1/4 SW 1/4

Forward the white, blue and pink copies to the Department of Health and Environment

Form WWC-5

BR 762