


USE TYPEWRITER OR BALL POINT PEN-PRESS FIRMLY, PRINT CLEARLY.

WATER WELL RECORD
KSA 82a-1201-1215

Kansas Department of Health and Environment-Division of Environment
(Water well Contractors)
Topeka, Kansas 66620

Location of well: **Jefferson** County Fraction **NE 1/4 NE 1/4 NE 1/4** Section number **Survey 19 20** Township number **T 11S** Range number **S R 18E** E/W

Distance and direction from nearest town or city: **2 1/2 mi. West of Perry, Ks. on U.S. 24** Street address of well location if in city:
3. Owner of well: **Mary Leach**
R.R. or street: **c/o Dale Hupe**
City, state, zip code: **Perry, Kansas 66073**

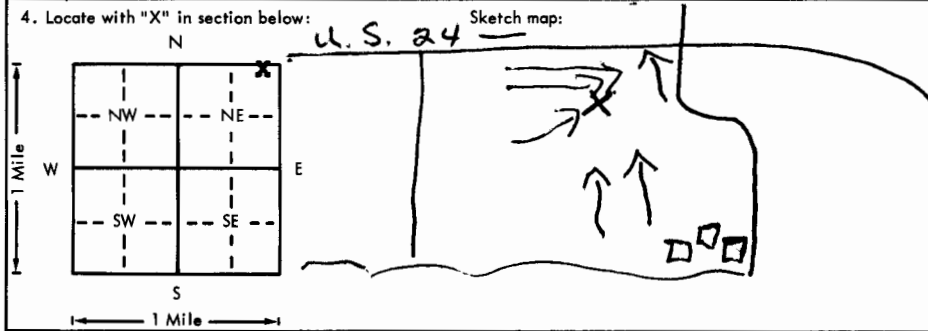

6. Bore hole dia. **30** in. Completion date **12-20-78**
Well depth **48** ft.

7. Cable tool Rotary Driven Dug
 Hollow rod Jetted Bored Reverse rotary

8. Use: Domestic Public supply Industry
 Irrigation Air conditioning Stock
 Lawn Oil field water Other

9. Casing: Material **steel** Height: (Above or below)
Threaded Welded Surface **12"** in.
RMP PVC Weight lbs./ft.
Dia. **16** in. to **28** ft. depth Wall Thickness: inches or
Dia. in. to ft. depth gage No. **219 w.t.**

5. Type and color of material	From	To
Hard black silt	0	5
Soft gray silt	5	9
Soft brown silt	9	29
Small to med. brown gray & brown silt	29	31
Med. brown gravel	31	40
Med. gray gravel & gray silt	40	45
Med. to large brown gravel & gray silt	45	47
Soft green shale	47	48
Soft gray clay-stopped.	48	
(Use a second sheet if needed)		

10. Screen: Manufacturer's name **Johnson UOP**
Type **cont. slot** Dia. **16"**
(Slot/gauge **100** Length **20'**
Set between **28** ft. and **48** ft.
Gravel pack? Size range of material **1/8-1/4"**

11. Static water level: **12** ft. below land surface Date **12-20-77**

12. Pumping level below land surfaces:
26 ft. after **1** hrs. pumping **800** g.p.m.
39 ft. after **3** hrs. pumping **850** g.p.m.
Estimated maximum yield **850** g.p.m.

13. Water sample submitted: **X** Yes No Date

14. Well head completion: Pitless adapter Inches above grade

15. Well grouted? **yes**
With: Neat cement Bentonite Concrete
Depth: From **0** ft. to **10** ft.

16. Nearest source of possible contamination: **house**
800 ft. Direction **SE** Type **laterals**
Well disinfected upon completion? Yes No

17. Pump: Not installed
Manufacturer's name HP Volts
Length of drop pipe ft. capacity g.p.m.
Type: Submersible Turbine
 Jet Reciprocating
 Centrifugal Other

18. Elevation: **850**
Topography: Hill Slope Upland Valley

19. Remarks:

20. Water well contractor's certification:
This well was drilled under my jurisdiction and this report is true to the best of my knowledge and belief.
Hoobler Drilling Co. License No. **323**
Address **St. Marys, Ks. 66536**
Signed **Douglas Hoobler** Date **1-5-78**
Authorized Representative

T 11 S R 18 E NE 1/4

BR < 802