


1 LOCATION OF WATER WELL: Fraction NW 1/4 NW 1/4 NW 1/4 Section Number 19 Township Number T 11 S Range Number R 18 EW  
 County: JEFFERSON

Distance and direction from nearest town or city street address of well if located within city?  
 3 WEST OF PEANY HS.

2 WATER WELL OWNER: MARK NEHRBASS  
 RR#, St. Address, Box #: RR1  
 City, State, ZIP Code: PEANY HS 66073  
 Board of Agriculture, Division of Water Resources  
 Application Number:

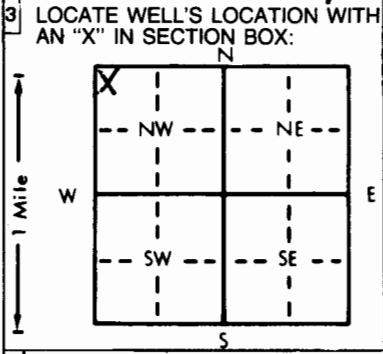

4 DEPTH OF COMPLETED WELL: 40 ft. ELEVATION:  
 Depth(s) Groundwater Encountered 1. 21 ft. 2. ft. 3. ft.  
 WELL'S STATIC WATER LEVEL 21 ft. below land surface measured on mo/day/yr NOV 15-89  
 Pump test data: Well water was ft. after hours pumping gpm  
 Est. Yield 40 gpm: Well water was ft. after hours pumping gpm  
 Bore Hole Diameter 10 in. to 40 ft., and in. to ft.  
 WELL WATER TO BE USED AS:  
 1 Domestic  3 Feedlot  6 Oil field water supply  9 Dewatering  12 Other (Specify below)  
 2 Irrigation  4 Industrial  7 Lawn and garden only  10 Monitoring well  
 Was a chemical/bacteriological sample submitted to Department? Yes  No ; If yes, mo/day/yr sample was submitted  
 Water Well Disinfected? Yes  No

5 TYPE OF BLANK CASING USED:  
 1 Steel  3 RMP (SR)  5 Wrought iron  8 Concrete tile CASING JOINTS:  Glued  Clamped  
 2 PVC  4 ABS  6 Asbestos-Cement  9 Other (specify below)  Welded  
 7 Fiberglass  Threaded  
 Blank casing diameter 5 in. to 35 ft., Dia in. to ft., Dia in. to ft.  
 Casing height above land surface 24 in., weight lbs./ft. Wall thickness or gauge No.  
 TYPE OF SCREEN OR PERFORATION MATERIAL:  
 1 Steel  3 Stainless steel  5 Fiberglass  7 PVC  10 Asbestos-cement  
 2 Brass  4 Galvanized steel  6 Concrete tile  9 ABS  12 None used (open hole)  
 SCREEN OR PERFORATION OPENINGS ARE:  
 1 Continuous slot  3 Mill slot  5 Gauzed wrapped  8 Saw cut  11 None (open hole)  
 2 Louvered shutter  4 Key punched  6 Wire wrapped  9 Drilled holes  
 7 Torch cut  10 Other (specify)  
 SCREEN-PERFORATED INTERVALS: From 35 ft. to 40 ft., From ft. to ft., From ft. to ft.  
 GRAVEL PACK INTERVALS: From 24 ft. to 40 ft., From ft. to ft., From ft. to ft.

6 GROUT MATERIAL: 1 Neat cement  2 Cement grout 3 Bentonite 4 Other  
 Grout Intervals: From 0 ft. to 24 ft., From ft. to ft., From ft. to ft.  
 What is the nearest source of possible contamination:  
 1 Septic tank  4 Lateral lines  7 Pit privy  10 Livestock pens  14 Abandoned water well  
 2 Sewer lines  5 Cess pool  8 Sewage lagoon  11 Fuel storage  15 Oil well/Gas well  
 3 Watertight sewer lines  6 Seepage pit  9 Feedyard  12 Fertilizer storage  16 Other (specify below)  
 13 Insecticide storage  
 Direction from well? N How many feet? 150

FROM	TO	LITHOLOGIC LOG	FROM	TO	PLUGGING INTERVALS
0	7	FILL			
7	22	CLAY YELLOW			
22	24	SOFT CLAY YELLOW			
34	40	GRAVEL BROWN CLEAN			

7 CONTRACTOR'S OR LANDOWNER'S CERTIFICATION: This water well was (1) constructed, (2) reconstructed, or (3) plugged under my jurisdiction and was completed on (mo/day/year) NOV 20-89 and this record is true to the best of my knowledge and belief. Kansas Water Well Contractor's License No. 119 This Water Well Record was completed on (mo/day/yr) DEC 25 89 under the business name of JOHN G. MANNING DRILLING by (signature) John G. Manning

060203000-13