

USE TYPEWRITER OR BALL POINT PEN-PRESS FIRMLY, PRINT CLEARLY.


WATER WELL RECORD
KSA 82a-1201-1215

bcb
20

Kansas Department of Health and Environment-Division of Environment (Water well Contractors) Topeka, Kansas 66620

1. Location of well: County **Jefferson** Fraction **On West line of** Section number **Fict. 20** Township number **T 11S** Range number **R 18E** E/W

2. Distance and direction from nearest town or city: **1 1/2 mi. West on US 24 & 1300' South from Perry, Ks.** Street address of well location if in city: **5608 Birch**
3. Owner of well: **Larry Glaser, M. D.** R.R. or street: **5608 Birch** City, state, zip code: **Shawnee Mission, Kansas**

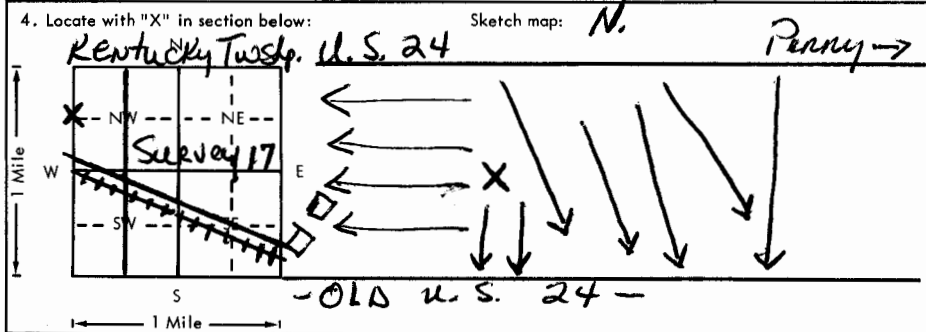

6. Bore hole dia. **30** in. Completion date **4-7-77**
Well depth **50** ft.
7. Cable tool Rotary Driven Dug
 Hollow rod Jetted Bored Reverse rotary
8. Use: Domestic Public supply Industry
 Irrigation Air conditioning Stock
 Lawn Oil field water Other
9. Casing: Material **Trans.** Height: (Above) or below
Threaded Welded Surface **24** in.
RMP PVC Weight _____ lbs./ft.
Dia. **16** in. to **24** ft. depth; Wall Thickness: inches or
Dia. _____ in. to _____ ft. depth; gage No. **.25"**

5. Type and color of material	From	To
Hard black soil	0	2
Hard light brown sand	2	7
Gray clay	7	28
Med. green gravel	28	35
Med. to large green gravel	35	38
Med. to large green gravel & clay	38	40
Med. to large green gravel	40	50
Hard green shale-stopped.	50	
(Use a second sheet if needed)		

10. Screen: Manufacturer's name **Johnson Well Co.**
Type **Transite** Dia. **16"**
(Slot) gauze **1/8 x 8** Length **26'**
Set between **24** ft. and **50** ft.
_____ ft. and _____ ft.
Gravel pack? **yes** Size range of material **1/8-1/4"**
11. Static water level: _____ mo./day/yr.
21 ft. below land surface Date **4-7-77**
12. Pumping level below land surfaces:
32 ft. after **1** hrs. pumping **400** g.p.m.
45 ft. after **3** hrs. pumping **500** g.p.m.
Estimated maximum yield **550** g.p.m.
13. Water sample submitted: _____ mo./day/yr.
Yes No Date _____
14. Well head completion: _____ Inches above grade
 Pitless adapter _____
15. Well grouted? **yes**
With: Neat cement Bentonite Concrete
Depth: From **0** ft. to **10** ft.
16. Nearest source of possible contamination:
ft. **1500** Direction **SW** Type **Farmstead**
Well disinfected upon completion? Yes No
17. Pump: Not installed
Manufacturer's name _____
Model number _____ HP _____ Volts _____
Length of drop pipe _____ ft. capacity _____ g.p.m.
Type:
 Submersible Turbine
 Jet Reciprocating
 Centrifugal Other

18. Elevation: **851**
Topography: Hill Slope Upland Valley
19. Remarks: **For flood irrigation. We do not install pumps.**

20. Water well contractor's certification:
This well was drilled under my jurisdiction and this report is true to the best of my knowledge and belief.
Hoobler Drilling Co. **323**
Business name License No.
Address **St. Marys, Ks. 66536**
Signed **Allen Hoobler** Date **4-13-77**
Authorized representative

T 11
R 18E
W 20
NW 20
1/4 1/4 1/4 1/4

Forward the white, blue and pink copies to the Department of Health and Environment

Form WWC-5

BR = 801
E = 830