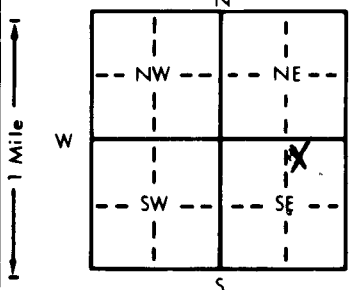


1 LOCATION OF WATER WELL: Fraction NW 1/4 NE 1/4 SE 1/4 Section Number 21 Township Number T 11 S Range Number R 18 E ~~XX~~
 County: Jefferson Distance and direction from nearest town or city street address of well if located within city?
 West of Perry on Old U.S. 24 - 3/4 W and 1200' N

2 WATER WELL OWNER: Mr. Dana Leibengood
 RR#, St. Address, Box #: 3009 W. 9th Board of Agriculture, Division of Water Resources
 City, State, ZIP Code: Lawrence, KS 66044 Application Number 37,006

3 LOCATE WELL'S LOCATION WITH AN "X" IN SECTION BOX:

 4 DEPTH OF COMPLETED WELL: 51 ft. ELEVATION:
 Depth(s) Groundwater Encountered 1. 14 ft. 2. ft. 3. ft.
 WELL'S STATIC WATER LEVEL: 14 ft. below land surface measured on mo/day/yr 5/19/84
 Pump test data: Well water was 25 ft. after 1 hours pumping 600 gpm
 Est. Yield 1200 gpm: Well water was 29 ft. after 1 hours pumping 1000 gpm
 Bore Hole Diameter: 32 in. to 51 ft., and in. to ft.
 WELL WATER TO BE USED AS:
 5 Public water supply 8 Air conditioning 11 Injection well
 1 Domestic 3 Feedlot 6 Oil field water supply 9 Dewatering 12 Other (Specify below)
 2 Irrigation 4 Industrial 7 Lawn and garden only 10 Observation well
 Was a chemical/bacteriological sample submitted to Department? Yes.....No.; If yes, mo/day/yr sample was submitted
 Water Well Disinfected? Yes No

5 TYPE OF BLANK CASING USED:
 1 Steel 3 RMP (SR) 5 Wrought iron 8 Concrete tile CASING JOINTS: Glued.....Clamped
 2 PVC 4 ABS 6 Asbestos-Cement 9 Other (specify below) Welded.....
 7 Fiberglass Threaded.....
 Blank casing diameter 16 in. to 36 ft., Dia in. to ft., Dia in. to ft.
 Casing height above land surface 12 in., weight lbs./ft. Wall thickness or gauge No.
 TYPE OF SCREEN OR PERFORATION MATERIAL:
 1 Steel 3 Stainless steel 5 Fiberglass 7 PVC 10 Asbestos-cement
 2 Brass 4 Galvanized steel 6 Concrete tile 8 RMP (SR) 11 Other (specify)
 9 ABS 12 None used (open hole)
 SCREEN OR PERFORATION OPENINGS ARE:
 1 Continuous slot 3 Mill slot 5 Gauzed wrapped 8 Saw cut 11 None (open hole)
 2 Louvered shutter 4 Key punched 6 Wire wrapped 9 Drilled holes
 7 Torch cut 10 Other (specify)
 SCREEN-PERFORATED INTERVALS: From 36 ft. to 51 ft., From ft. to ft.
 From ft. to ft., From ft. to ft.
 GRAVEL PACK INTERVALS: From 10 ft. to 51 ft., From ft. to ft.
 From ft. to ft., From ft. to ft.

6 GROUT MATERIAL: 1 Neat cement 2 Cement grout 3 Bentonite 4 Other.....
 Grout Intervals: From 0 ft. to 10 ft., From ft. to ft., From ft. to ft.
 What is the nearest source of possible contamination:
 1 Septic tank 4 Lateral lines 7 Pit privy 10 Livestock pens 14 Abandoned water well
 2 Sewer lines 5 Cess pool 8 Sewage lagoon 11 Fuel storage 15 Oil well/Gas well
 3 Watertight sewer lines 6 Seepage pit 9 Feedyard 12 Fertilizer storage 16 Other (specify below)
 13 Insecticide storage ... Old Channel.....
 Direction from well? How many feet? 100'

FROM	TO	LITHOLOGIC LOG	FROM	TO	LITHOLOGIC LOG
0	6	Heavy Balck Silt			
6	9	log'			
9	12	Brown Silt			
12	19	sml brwn gravel			
19	23	md. brwn gravel & gray clay			
23	36	" " " " clear			
36	38	small gray gravel & gray clay			
38	40	md-lg gray gravel XXXX gray clay			
40	41	med-gray gravel clear			
41	43	fine gray sand			
43	44	small gray gravel			
44	45	fine gray sand			
45	48	med. gray gravel			
48	51	lg-md gray gravel & lg rocks			
	51	brown shale			

7 CONTRACTOR'S OR LANDOWNER'S CERTIFICATION: This water well was (1) constructed, (2) reconstructed, or (3) plugged under my jurisdiction and was completed on (mo/day/year) 5-17-84 and this record is true to the best of my knowledge and belief. Kansas Water Well Contractor's License No. 323 This Water Well Record was completed on (mo/day/yr) 5-21-84 under the business name of Hoobler Drilling Company by (signature) *Dana Leibengood*

INSTRUCTIONS: Use typewriter or ball point pen, PLEASE PRESS FIRMLY and PRINT clearly. Please fill in blanks, underline or circle the correct answers. Send top three copies to Kansas Department of Health and Environment, Division of Environment, Environmental Geology Section, Topeka, KS 66620. Send one to WATER WELL OWNER and retain one for your records.