15

Sent 5-18-76 ✓BRI

USE TYPEWRITER OR BALL POINT PEN-PRESS FIRMLY, PRINT CLEARLY.

dcc

T R EW sec 1/4 1/4 1/4 No.

WATER WELL RECORD
KSA 82a-1201-1215

Kansas State Dept. Of Health
(Water Well Contractors)
Forbes-Bldg. 740
Topeka, Kansas 66620

SW SW SE 22 11S

1 Location of well:	County	Township name	Fraction	Section number	Town number	Range number
	Jefferson	Hamlin	Sub division	LOT #3	Perry Kansas	18E

Distance and direction from nearest town or city:

Street address of well location if in city: Hamlin Sub division 112 Walnut Court

3 Owner of well: Albert Hamlin

Address: Perry Kansas

Locate with "X" in section below:

Sketch map:

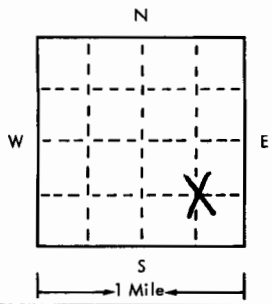

2

Type and color of material	From	To
Surface	0	12'
Clay	12'	15'
Sand	15'	22'
Sand - Gravel	22'	30'
Coarse Gravel	30'	50'

(use a second sheet if needed)

4 Well depth: 50 ft. Date of completion 5-13-76
Well diameter ~~8~~ in. 12"

5 ☑ Cable tool ☐ Rotary ☐ Driven ☐ Dug
☐ Hollow rod ☐ Jetted ☐ Bored ☐ Reverse rotary

6 Use: ☑ Domestic ☐ Public supply ☐ Industry
☐ Irrigation ☐ Air conditioning ☐ Commercial
☐ Test well ☐ _____

7 Casing: Material Steel Height: above/below
Threaded ☐ Welded ☑ Surface 32 in.
Diam. Weight 13 lbs./ft.
6 in. to 50 ft. depth Drive shoe? ☐ Yes ☐ No
___ in. to ___ ft. depth

8 Screen:
Manufacturer Johnson Plastic
Type Plastic Dia. 5"
Slot/gauze 1/32" Length 18'
Set between 32 ft. and 50 ft.
Fittings:
Gravel pack ☑ Yes ☐ No Size range of material 1/4"

9 Static water level:
18 ft. below land surface Date 5-13-76

10 Pumping level below land surfaces:
___ ft. after ___ hrs. pumping ___ g.p.m.
___ ft. after ___ hrs. pumping ___ g.p.m.
Estimated maximum yield 15 g.p.m.

11 Water sample submitted:
☐ Yes ☑ No Date _____

12 Well head completion:
☑ Pitless adapter ☐ Inches above grade

13 Well grouted? ☑ Yes ☐ No
☑ Neat cement ☐ Bentonite ☐ _____
Depth: From 15 ft. to 3 ft.

14 Nearest source of possible contamination: ~~House~~ Line
ft. 30 Direction S Type Sewer
Well disinfected upon completion? ☒ Yes ☐ No

15 Pump: ☑ Not installed
Manufacturer's name _____
Model number _____ HP _____ Volts _____
Length of drop pipe _____ ft. capacity _____ g.m.p.
Type:
☐ Submersible ☐ Turbine
☐ Jet ☐ Reciprocating
☐ Certrifugal ☐ Other

16 Remarks: elevation 49' ~~854~~

Topography:
☐ Hill
☐ Slope
☐ Upland
☑ Valley

17 Water well contractor's certification:
This well was drilled under my jurisdiction and this report is true to the best of my knowledge and belief.
Perry Drilling Co 155
Business name License No.
Address Perry Kansas
Signed Wallace Shaw Date 5-13-76
Authorized representative

Forward the white, blue and pink copies to the Kansas State Dept. Of Health.

Form WWC-5

BR < ~~800~~ 749

▽ = 832'

11 18E 22 SW SW SE

P
DJ