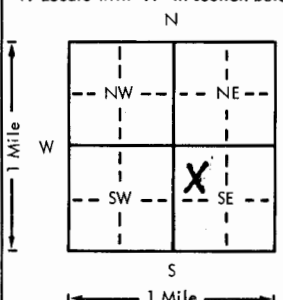


USE TYPEWRITER OR BALL
POINT PEN-PRESS FIRMLY,
PRINT CLEARLY.

WATER WELL RECORD
KSA 82a-1201-1215

Kansas Department of Health and
Environment-Division of Environment
(Water well Contractors)
Topeka, Kansas 66620

1. Location of well:	County Jefferson	Fraction SW 1/4 NW 1/4 SE 1/4	Section number 22	Township number T 11	Range number S R 18 E/W
2. Distance and direction from nearest town or city: In Perry			3. Owner of well: Perry schools		
Street address of well location if in city:			R.R. or street: middle school		
4. Locate with "X" in section below:			City, state, zip code: Perry, Kansas 66073		
Sketch map:			6. Bore hole dia. 10 in. Completion date 4-25-79		
			Well depth 60 ft.		
			7. <input checked="" type="checkbox"/> Cable tool <input checked="" type="checkbox"/> Rotary <input type="checkbox"/> Driven <input type="checkbox"/> Dug <input type="checkbox"/> Hollow rod <input type="checkbox"/> Jetted <input type="checkbox"/> Bored <input type="checkbox"/> Reverse rotary		
			8. Use: <input type="checkbox"/> Domestic <input type="checkbox"/> Public supply <input type="checkbox"/> Industry <input type="checkbox"/> Irrigation <input type="checkbox"/> Air conditioning <input type="checkbox"/> Stock <input checked="" type="checkbox"/> Lawn <input type="checkbox"/> Oil field water <input type="checkbox"/> Other		
			9. Casing: Material PVC Height: Above or below Threaded <input type="checkbox"/> Welded <input type="checkbox"/> Surface 24 in. RMP <input type="checkbox"/> PVC 9L Weight 2.82 lbs./ft. Dia. 5 in. to 60 ft. depth Wall Thickness: inches or Dia. <input type="checkbox"/> in. to <input type="checkbox"/> ft. depth gage No. 250		
5. Type and color of material			From	To	10. Screen: Manufacturer's name Pumpco MPI
TOP SOIL			0	6	Type PVC Dia. 5
Clay, brown			6	30	Slot gauge .060 Length 10
FINE SAND, COARSE SAND			30	45	Set between 50 ft. and 60 ft.
COARSE SAND, GRAVEL, WATER BEARING			45	60	Gravel pack? <input checked="" type="checkbox"/> Size range of material 24x12
					11. Static water level: 25 ft. below land surface Date 4-25-79
					12. Pumping level below land surfaces: ____ ft. after ____ hrs. pumping ____ g.p.m. ____ ft. after ____ hrs. pumping ____ g.p.m. Estimated maximum yield 100 g.p.m.
					13. Water sample submitted: ____ mo./day/yr. <input checked="" type="checkbox"/> Yes <input checked="" type="checkbox"/> No Date
					14. Well head completion: CAP <input type="checkbox"/> Pitless adapter 24 inches above grade
					15. Well grouted? <input checked="" type="checkbox"/> With: <input checked="" type="checkbox"/> Neat cement <input type="checkbox"/> Bentonite <input type="checkbox"/> Concrete Depth: From 0 ft. to 30 ft.
					16. Nearest source of possible contamination: ft. 150 Direction W Type Drainage Well disinfected upon completion? <input type="checkbox"/> Yes <input type="checkbox"/> No
					17. Pump: <input checked="" type="checkbox"/> Not installed Manufacturer's name _____ Model number _____ HP _____ Volts _____ Length of drop pipe _____ ft. capacity _____ g.p.m. Type: <input type="checkbox"/> Submersible <input type="checkbox"/> Turbine <input type="checkbox"/> Jet <input type="checkbox"/> Reciprocating <input type="checkbox"/> Centrifugal <input type="checkbox"/> Other
					18. Elevation: 847'
					19. Remarks: OWNER TO INSTALL SLAB
					20. Water well contractor's certification: This well was drilled under my jurisdiction and this report is true to the best of my knowledge and belief. STRADE DALE CO INC 182 Business name License No. Address RT 1 HOLTON, KS Signed Dale Perkins Date 4-27-79 Authorized representative

Forward the white, blue and pink copies to the Department of Health and Environment

Form WWC-5