

V1311

USE TYPEWRITER OR BALL POINT PEN-PRESS FIRMLY, PRINT CLEARLY.

WATER WELL RECORD
KSA 82a-1201-1215

T R EW sec 1/4 1/4 1/4 No.



Kansas State Dept. Of Health
(Water Well Contractors)
Forbes-Bldg. 740
Topeka, Kansas 66620

32a
cac
SW NE SW
SW corner NE 1/4 SW 1/4 Sec 23

1 Location of well:	County Jefferson	Township name 11 South	Fraction N 1/2 SW 1/4	Section number 23	Town number 11 S	Range number 18 East
---------------------	----------------------------	----------------------------------	---------------------------------	-----------------------------	----------------------------	--------------------------------

Distance and direction from nearest town or city: 1/4 mile east of Perry Street address of well location if in city:	3 Owner of well: Perry High School Address: Perry Kansas
---	---

Locate with "X" in section below:	Sketch map:	<p>4 Well depth: 59 ft. Date of completion 8-8-77 Well diameter 6 in.</p> <p>5 <input checked="" type="checkbox"/> Cable tool <input type="checkbox"/> Rotary <input type="checkbox"/> Driven <input type="checkbox"/> Dug <input type="checkbox"/> Hollow rod <input type="checkbox"/> Jetted <input type="checkbox"/> Bored <input type="checkbox"/> Reverse rotary</p> <p>6 Use: <input type="checkbox"/> Domestic <input type="checkbox"/> Public supply <input type="checkbox"/> Industry <input checked="" type="checkbox"/> Irrigation <input type="checkbox"/> Air conditioning <input type="checkbox"/> Commercial <input type="checkbox"/> Test well</p> <p>7 Casing: Material steel Height: <u>above/below MHC</u> Threaded <input type="checkbox"/> Welded <input checked="" type="checkbox"/> Surface 12 in. Diam. _____ Weight 5 lbs./ft. _____ 6 in. to 37 ft. depth Drive shoe? <input type="checkbox"/> Yes <input checked="" type="checkbox"/> No _____ in. to _____ ft. depth</p>
-----------------------------------	-------------	--

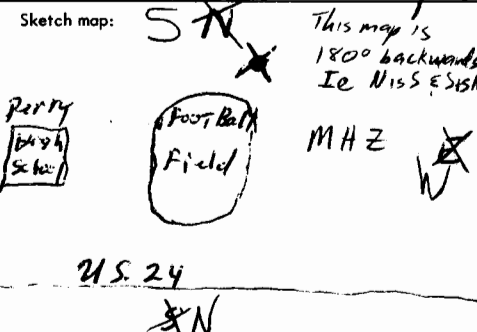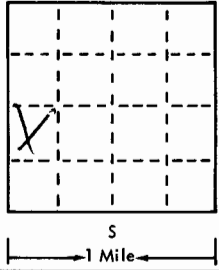

2 Type and color of material	From	To
Surface	0	15
Sand	15	22
Coarse sand	22	27
Sand + gravel	27	59
(use a second sheet if needed)		

<p>8 Screen: Manufacturer Sunflower Plastic Type Plastic Dia. 5 1/2 Slot/gauze 1/4 Length 20 Set between 32 ft. and 58 ft. Fittings: Gravel pack <input type="checkbox"/> Yes <input type="checkbox"/> No Size range of material _____</p> <p>9 Static water level: 22 ft. below land surface Date 8-8-77</p> <p>10 Pumping level below land surfaces: 27 ft. after 1 hrs. pumping 25 g.p.m. _____ ft. after _____ hrs. pumping _____ g.p.m. Estimated maximum yield 35 g.p.m.</p> <p>11 Water sample submitted: <input type="checkbox"/> Yes <input checked="" type="checkbox"/> No Date _____</p> <p>12 Well head completion: <input checked="" type="checkbox"/> Pitless adapter <input type="checkbox"/> Inches above grade</p> <p>13 Well grouted? <input checked="" type="checkbox"/> Yes <input type="checkbox"/> No <input checked="" type="checkbox"/> Neat cement <input type="checkbox"/> Bentonite _____ Depth: From 13 ft. to 3 ft.</p> <p>14 Nearest source of possible contamination: ft. _____ Direction _____ Type _____ Well disinfected upon completion? <input checked="" type="checkbox"/> Yes <input type="checkbox"/> No</p> <p>15 Pump: <input checked="" type="checkbox"/> Not installed Manufacturer's name _____ Model number _____ HP _____ Volts _____ Length of drop pipe _____ ft. capacity _____ g.m.p. Type: <input type="checkbox"/> Submersible <input type="checkbox"/> Turbine <input type="checkbox"/> Jet <input type="checkbox"/> Reciprocating <input type="checkbox"/> Centrifugal <input type="checkbox"/> Other</p>
--

<p>16 Remarks: elevation well is to be used for watering grass at football field. legal description on separate sheet.</p> <p>Topography: <input type="checkbox"/> Hill <input type="checkbox"/> Slope <input type="checkbox"/> Upland <input checked="" type="checkbox"/> Valley</p>	<p>17 Water well contractor's certification: This well was drilled under my jurisdiction and this report is true to the best of my knowledge and belief. Perry Drilling Co K-155 Business name License No. _____ Address Perry Kansas Signed Wm. Thacker Date 9-7-77 Authorized representative</p>
---	--

El. 850 MHZ (Exact)

11 18E 23 N1/2 SW

Forward the white, blue and pink copies to the Kansas State Dept. Of Health.

Form WWC-5

BRK 791 7 = 828

877-H