


WATER WELL RECORD Form WWC-5 KSA 82a-1212

1 LOCATION OF WATER WELL: County: Jefferson Fraction S¹/₂ 1/₄ S¹/₂ 1/₄ N.E. 1/₄ Section Number 26 Township Number T 11 S Range Number R 18 **EW**

Distance and direction from nearest town or city street address of well if located within city? 1 1/2 S. & 1/4 E. of E. edge of Perry Ks.

2 WATER WELL OWNER: Alan M. Hill
 RR#, St. Address, Box #: 3669 S.E. Arrowhead Dr. Board of Agriculture, Division of Water Resources
 City, State, ZIP Code: Topeka, Ks. 66605 Application Number: 39385

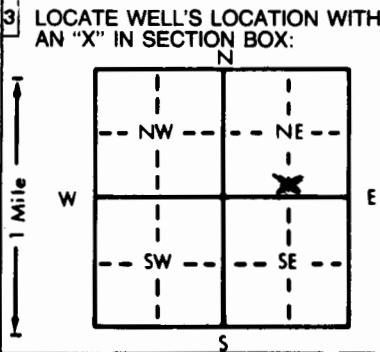

4 DEPTH OF COMPLETED WELL: 64 ft. ELEVATION: _____ ft.

Depth(s) Groundwater Encountered 1 19 ft. 2 ft. 3 ft.

WELL'S STATIC WATER LEVEL 19 ft. below land surface measured on mo/day/yr 6-9-89

Pump test data: Well water was 28 ft. after 1 hours pumping 700 gpm
 Est. Yield 1000 gpm: Well water was 37 ft. after 2 hours pumping 800 gpm

Bore Hole Diameter 32 in. to 64 in. to _____ ft. and _____ in. to _____ ft.

WELL WATER TO BE USED AS:
 5 Public water supply 8 Air conditioning 11 Injection well
 1 Domestic 3 Feedlot 6 Oil field water supply 9 Dewatering 12 Other (Specify below)
 2 Irrigation 4 Industrial 7 Lawn and garden only 10 Observation well

Was a chemical/bacteriological sample submitted to Department? Yes _____ No XX; If yes, mo/day/yr sample was submitted _____
 Water Well Disinfected? Yes _____ No X

5 TYPE OF BLANK CASING USED:
 1 Steel 3 RMP (SR) 5 Wrought iron 8 Concrete tile CASING JOINTS: Glued X Clamped _____
 2 PVC 4 ABS 6 Asbestos-Cement 9 Other (specify below) Welded _____
 7 Fiberglass Threaded _____

Blank casing diameter 16 in. to 44 in. Dia _____ in. to _____ in. Dia _____ in. to _____ ft.

Casing height above land surface 12 in., weight _____ lbs./ft. Wall thickness or gauge No. 65

TYPE OF SCREEN OR PERFORATION MATERIAL:
 1 Steel 3 Stainless steel 5 Fiberglass 7 PVC 10 Asbestos-cement
 2 Brass 4 Galvanized steel 6 Concrete tile 8 RMP (SR) 11 Other (specify) _____
 12 None used (open hole)

SCREEN OR PERFORATION OPENINGS ARE:
 1 Continuous slot 3 Mill slot 5 Gauzed wrapped 8 Saw cut 11 None (open hole)
 2 Louvered shutter 4 Key punched 6 Wire wrapped 9 Drilled holes
 7 Torch cut 10 Other (specify) _____

SCREEN-PERFORATED INTERVALS: From 44 ft. to 64 ft. From _____ ft. to _____ ft.
 From _____ ft. to _____ ft. From _____ ft. to _____ ft.

GRAVEL PACK INTERVALS: From 19 ft. to 64 ft. From _____ ft. to _____ ft.
 From _____ ft. to _____ ft. From _____ ft. to _____ ft.

6 GROUT MATERIAL: 1 Neat cement 2 Cement grout 3 Bentonite 4 Other _____

Grout Intervals: From 0 ft. to 19 ft. From _____ ft. to _____ ft. From _____ ft. to _____ ft.

What is the nearest source of possible contamination:
 1 Septic tank 4 Lateral lines 7 Pit privy 10 Livestock pens 14 Abandoned water well
 2 Sewer lines 5 Cess pool 8 Sewage lagoon 11 Fuel storage 15 Oil well/Gas well
 3 Watertight sewer lines 6 Seepage pit 9 Feedyard 12 Fertilizer storage 16 Other (specify below)
 13 Insecticide storage 17 Waterway

Direction from well? N. How many feet? 200

FROM	TO	LITHOLOGIC LOG	FROM	TO	LITHOLOGIC LOG
0	1	Black silt			
1	16	Fine brown sandy silt			
16	19	Small-medium brown sand			
19	25	Small-medium brown gravel			
25	29	Medium-large brown gravel			
29	34	Small-medium brown gravel			
34	35	Medium brown sand			
35	37	Small grey gravel			
37	54	Medium-large grey gravel			
54	56	Large brown gravel & large rocks			
56	64	Medium-large brown gravel & large rocks			
	64	Red shale Stopped			

7 CONTRACTOR'S OR LANDOWNER'S CERTIFICATION: This water well was (1) constructed, (2) reconstructed, or (3) plugged under my jurisdiction and was completed on (mo/day/year) 6-8-89 and this record is true to the best of my knowledge and belief. Kansas Water Well Contractor's License No. 323 This Water Well Record was completed on (mo/day/yr) 7-1-89 under the business name of Hoobler Drilling Co. by (signature) Daniel Hoobler

INSTRUCTIONS: Use typewriter or ball point pen. PLEASE PRESS FIRMLY and PRINT clearly. Please fill in blanks, underline or circle the correct answers. Send top three copies to Kansas Department of Health and Environment, Office of Oil Field and Environmental Geology, Regulation and Permitting Section, Topeka, Kansas 66620-7500, Telephone: 913-862-9360. Send one to WATER WELL OWNER and retain one for your records.