

USE TYPEWRITER OR BALL POINT PEN-PRESS FIRMLY, PRINT CLEARLY.


WATER WELL RECORD
KSA 82a-1201-1215

Kansas Department of Health and Environment
Division of Environment
(Water well Contractors)
Topeka, Kansas 66620

NE SE SW edb

1. Location of well: County Jefferson Fraction SE 1/4 SW 1/4 Section number 20 Township number T 11S Range number S R 18E E/W

2. Distance and direction from nearest town or city: 1 1/2 mi. West of Perry, Ks. on old U.S. 24
Street address of well location if in city: + 1/8 mi. N.
3. Owner of well: L. F. Glaser
R.R. or street: 5608 Birch
City, state, zip code: Shawnee Mission, Ks. 66205

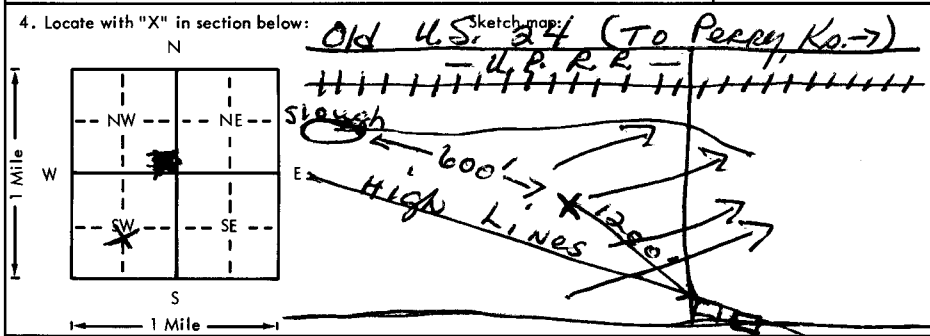

6. Bore hole dia. 30 in. Completion date 12-15-77
Well depth 37 ft.
7. Cable tool Rotary Driven Dug
 Hollow rod Jetted Bored Reverse rotary
8. Use: Domestic Public supply Industry
 Irrigation Air conditioning Stock
 Lawn Oil field water Other
9. Casing: Material steel Height (Above or below surface) 12 in.
Threaded Welded Surface 12 in.
RMP PVC Weight lbs./ft.
Dia. 16 in. to 17 ft. depth Wall Thickness: inches or
Dia. in. to ft. depth Gauge No. 029

| 5. Type and color of material | From | To |
|---------------------------------------|------|----|
| Dark brown silty sand | 0 | 2 |
| Fine brown silty sand | 2 | 7 |
| Small brown gravel & fine brown sand | 7 | 13 |
| Small brown gravel & gray silt | 13 | 15 |
| Small to med. brown gravel | 15 | 18 |
| Small to med. gray gravel & gray silt | 18 | 21 |
| Med. gray gravel & gray silt | 21 | 29 |
| Med. gray gravel | 29 | 34 |
| Med. to large gray gravel | 34 | 37 |
| Limestone-stopped. | 37 | |

10. Screen: Manufacturer's name Free-Flo W. A. Brown Enterprises
Type steel Dia. 16"
Slot/gauze 1/8 x 2 Length 20'
Set between 36 ft. and 16 ft.
 ft. and ft.
Gravel pack? yes Size range of material 5/8"
11. Static water level: 7 ft. below land surface Date 12-15-77 mo./day/yr.
12. Pumping level below land surfaces:
20 ft. after 1 hrs. pumping 500 g.p.m.
28 ft. after 3 hrs. pumping 700 g.p.m.
Estimated maximum yield 800 g.p.m.
13. Water sample submitted: 800 g.p.m. mo./day/yr.
Yes No Date _____
14. Well head completion: Pitless adapter _____ Inches above grade
15. Well grouted? yes
With: Neat cement Bentonite Concrete
Depth: From 0 ft. to 10 ft.
16. Nearest source of possible contamination: ft. 600 Direction west Type pot hole
Well disinfected upon completion? Yes No
17. Pump: Not installed
Manufacturer's name _____
Model number _____ HP _____ Volts _____
Length of drop pipe _____ ft. capacity _____ g.p.m.
Type: Submersible Turbine
 Jet Reciprocating
 Centrifugal Other

18. Elevation: 850
Topography: Hill Slope Upland Valley
19. Remarks: (Use a second sheet if needed)

20. Water well contractor's certification:
This well was drilled under my jurisdiction and this report is true to the best of my knowledge and belief.
Hoobler Drilling Co. 323
Business name License No.
Address St. Marys, Ks. 66536
Signed Don Hoobler Date 12-28-77
Authorized representative