


1 LOCATION OF WATER WELL: County: Jefferson	Fraction SE 1/4 NW 1/4 NE 1/4	Section Number 25	Township Number T 11 S	Range Number R 18 E/W
---	---	-----------------------------	----------------------------------	---------------------------------

Distance and direction from nearest town or city street address of well if located within city?
 Approximately 1 3/4 miles east and 1/4 mile south of Perry

2 WATER WELL OWNER: **Jefferson County RWD #2**
 RR#, St. Address, Box # : **11642 31st St.** Board of Agriculture, Division of Water Resources
 City, State, ZIP Code : **Perry, KS 66073** Application Number: **43,059**

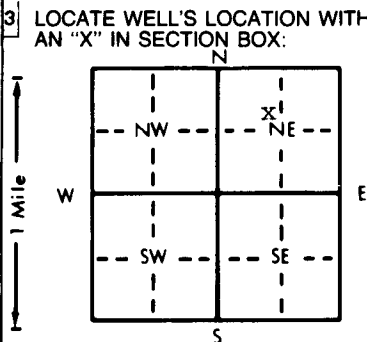

4 DEPTH OF COMPLETED WELL: **74** ft. ELEVATION: **unknown**
 Depth(s) Groundwater Encountered 1. ft. 2. ft. 3. ft.
 WELL'S STATIC WATER LEVEL: **14** ft. below land surface measured on mo/day/yr **8/26/98**
 Pump test data: Well water was **not ch'd** ft. after hours pumping gpm
 Est. Yield **unknown** gpm: Well water was ft. after hours pumping gpm
 Bore Hole Diameter: **38** in. to **74** ft., and in. to ft.
 WELL WATER TO BE USED AS:
 5 Public water supply 8 Air conditioning 11 Injection well
 1 Domestic 3 Feedlot 6 Oil field water supply 9 Dewatering 12 Other (Specify below)
 2 Irrigation 4 Industrial 7 Lawn and garden only 10 Monitoring well
 Was a chemical/bacteriological sample submitted to Department? Yes.....No.....X.....; If yes, mo/day/yr sample was submitted
 Water Well Disinfected? Yes No

5 TYPE OF CASING USED:
 1 Steel 3 RMP (SR) 5 Wrought iron 8 Concrete tile CASING JOINTS: Glued Clamped
 2 PVC 4 ABS 6 Asbestos-Cement 9 Other (specify below) Welded
 7 Fiberglass Threaded.....
 Blank casing diameter **12 3/4** in. to **52.5** ft., Dia in. to ft., Dia in. to ft.
 Casing height above land surface: **6** in., weight **49.56** lbs./ft. Wall thickness or gauge No. **.375**
 TYPE OF SCREEN OR PERFORATION MATERIAL:
 1 Steel 3 Stainless steel 5 Fiberglass 7 PVC 10 Asbestos-cement
 2 Brass 4 Galvanized steel 6 Concrete tile 8 RMP (SR) 11 Other (specify)
 9 ABS 12 None used (open hole)
 SCREEN OR PERFORATION OPENINGS ARE:
 1 Continuous slot 3 Mill slot 5 Gauzed wrapped 8 Saw cut 11 None (open hole)
 2 Louvered shutter 4 Key punched 6 Wire wrapped 9 Drilled holes
 7 Torch cut 10 Other (specify)
 SCREEN-PERFORATED INTERVALS: From **52.5** ft. to **73.5** ft., From ft. to ft.
 From ft. to ft., From ft. to ft.
 GRAVEL PACK INTERVALS: From **40** ft. to **74** ft., From ft. to ft.
 From ft. to ft., From ft. to ft.

6 GROUT MATERIAL: 1 Neat cement 2 Cement grout 3 Bentonite 4 Other **50% Bentonite Holeplug & 50% Sand**
 Grout Intervals: From **0** ft. to **5** ft., From **5** ft. to **26** ft., From **26** ft. to **40** ft.
 What is the nearest source of possible contamination:
 1 Septic tank 4 Lateral lines 7 Pit privy 10 Livestock pens 14 Abandoned water well
 2 Sewer lines 5 Cess pool 8 Sewage lagoon 11 Fuel storage 15 Oil well/Gas well
 3 Watertight sewer lines 6 Seepage pit 9 Feedyard 12 Fertilizer storage 16 Other (specify below)
 13 Insecticide storage **None known**
 Direction from well? How many feet?

FROM	TO	LITHOLOGIC LOG	FROM	TO	PLUGGING INTERVALS
0	2	Topsoil			
2	9	Clay, dark brown			
9	18	Sand, fine, medium			
18	20	Clay, brown, soft, sticky			
20	24	Sand, very fine			
24	44	Sand and gravel, fine, medium			
44	56	Sand and gravel, fine, medium, coarse			
56	62	Sand and gravel, fine, medium, coarse, some rock			
62	62.5	Clay, light gray			
62.5	74	Sand and gravel, medium, coarse, very coarse			

7 CONTRACTOR'S OR LANDOWNER'S CERTIFICATION: This water well was (1) constructed, (2) reconstructed, or (3) plugged under my jurisdiction and was completed on (mo/day/year) **8/26/98** and this record is true to the best of my knowledge and belief. Kansas Water Well Contractor's License No. **185** This Water Well Record was completed on (mo/day/yr) **9/10/98**
 under the business name of **Clarke Well & Equipment, Inc.** by (signature) *Clarke Well & Equipment, Inc.*

OFFICE USE ONLY
T
R
EW
SEC