


1 LOCATION OF WATER WELL: County: Jefferson	Fraction SW ¼ NW ¼ NE ¼	Section Number 25	Township Number T 11 S	Range Number R 18 EXX
--	----------------------------	----------------------	---------------------------	--------------------------

Distance and direction from nearest town or city street address of well if located within city?

Approximately 1 3/4 miles east and 1/4 mile south of Perry

2 WATER WELL OWNER: Jefferson County RWD #2
 RR#, St. Address, Box #: 11642 31st St. Board of Agriculture, Division of Water Resources
 City, State, ZIP Code: Perry, KS 66073 Application Number: 43,059

3 LOCATE WELL'S LOCATION WITH AN "X" IN SECTION BOX:

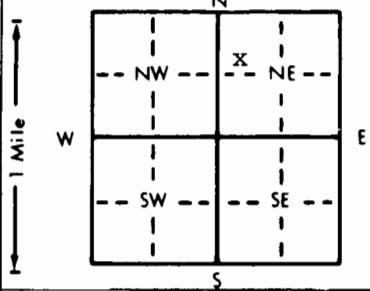

4 DEPTH OF COMPLETED WELL: 72 ft. ELEVATION: unknown
 Depth(s) Groundwater Encountered 1. ft. 2. ft. 3. ft.
 WELL'S STATIC WATER LEVEL 14 ft. below land surface measured on mo/day/yr 8/28/98
 Pump test data: Well water was not ch'd. ft. after hours pumping gpm
 Est. Yield unknown gpm: Well water was ft. after hours pumping gpm
 Bore Hole Diameter 38 in. to 71 ft., and in. to ft.
 WELL WATER TO BE USED AS:
 1 Domestic 3 Feedlot 5 Public water supply 8 Air conditioning 11 Injection well
 2 Irrigation 4 Industrial 6 Oil field water supply 9 Dewatering 12 Other (Specify below)
 7 Lawn and garden only 10 Monitoring well
 Was a chemical/bacteriological sample submitted to Department? Yes No ; If yes, mo/day/yr sample was submitted
 Water Well Disinfected? Yes No

5 TYPE OF BLANK CASING USED:
 1 Steel 3 RMP (SR) 5 Wrought iron 8 Concrete tile CASING JOINTS: Glued Clamped
 2 PVC 4 ABS 6 Asbestos-Cement 9 Other (specify below) Welded
 7 Fiberglass Threaded
 Blank casing diameter 12 3/4 in. to 50 ft., Dia in. to ft., Dia in. to ft.
 Casing height above land surface 12 in., weight 49.56 lbs./ft. Wall thickness or gauge No. 37.5
 TYPE OF SCREEN OR PERFORATION MATERIAL:
 1 Steel 3 Stainless steel 5 Fiberglass 7 PVC 10 Asbestos-cement
 2 Brass 4 Galvanized steel 6 Concrete tile 8 RMP (SR) 11 Other (specify)
 9 ABS 12 None used (open hole)
 SCREEN OR PERFORATION OPENINGS ARE:
 1 Continuous slot 3 Mill slot 5 Gauzed wrapped 8 Saw cut 11 None (open hole)
 2 Louvered shutter 4 Key punched 6 Wire wrapped 9 Drilled holes
 7 Torch cut 10 Other (specify)
 SCREEN-PERFORATED INTERVALS: From 50 ft. to 71 ft., From ft. to ft.
 From ft. to ft., From ft. to ft.
 GRAVEL PACK INTERVALS: From 40 ft. to 71 ft., From ft. to ft.
 From ft. to ft., From ft. to ft.

6 GROUT MATERIAL: 1 Neat cement 2 Cement grout 3 Bentonite 4 Other 50% Bentonite Holeplug & 50% Sand
 Grout Intervals: From 0 ft. to 5 ft., From 5 ft. to 26 ft., From 26 ft. to 40 ft.
 What is the nearest source of possible contamination:
 1 Septic tank 4 Lateral lines 7 Pit privy 10 Livestock pens 14 Abandoned water well
 2 Sewer lines 5 Cess pool 8 Sewage lagoon 11 Fuel storage 15 Oil well/Gas well
 3 Watertight sewer lines 6 Seepage pit 9 Feedyard 12 Fertilizer storage 16 Other (specify below)
 13 Insecticide storage None known

Direction from well? _____ How many feet? _____

FROM	TO	LITHOLOGIC LOG	FROM	TO	PLUGGING INTERVALS
0	2	Topsoil			
2	5	Clay, dark brown			
5	15	Clay, brown			
15	35	Sand, fine, medium			
35	45	Sand and gravel, fine, medium, coarse			
45	55	Sand and gravel, fine medium			
55	70	Sand and gravel, fine, medium, coarse with rocks			
70	71	Sand and gravel, coarse with rocks			

7 CONTRACTOR'S OR LANDOWNER'S CERTIFICATION: This water well was (1) constructed, (2) reconstructed, or (3) plugged under my jurisdiction and was completed on (mo/day/year) 8/28/98 and this record is true to the best of my knowledge and belief. Kansas Water Well Contractor's License No. 185 This Water Well Record was completed on (mo/day/yr) 9/10/98 under the business name of Clarke Well & Equipment, Inc. by (signature) *Clarke Well & Equipment, Inc.*