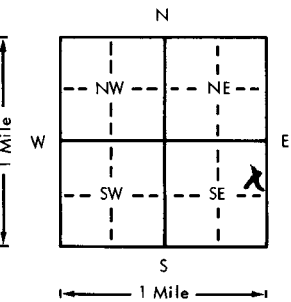



USE TYPEWRITER OR BALL POINT PEN-PRESS FIRMLY, PRINT CLEARLY.

WATER WELL RECORD  
KSA 82a-1201-1215

*dad*

Kansas Department of Health and Environment-Division of Environment (Water well Contractors) Topeka, Kansas 66620

1. Location of well:	County <b>Jefferson</b>	Fraction <b>SE 1/4 NE 1/4 SE 1/4</b>	Section number <b>26</b>	Township number <b>T 11 S</b>	Range number <b>R 18 E E/W</b>
2. Distance and direction from nearest town or city:	<b>1 mi south 1/4 East of Perry</b>		3. Owner of well:	<b>Bob Russell</b>	
Street address of well location if in city:			R.R. or street:	<b>754 Sunset Dr</b>	
			City, state, zip code:	<b>Lawrence, KS 66044</b>	
4. Locate with "X" in section below:	Sketch map:		6. Bore hole dia. <b>8 1/2" in.</b>	Completion date <b>4-23-78</b>	
			Well depth _____ ft.		
			7. <input checked="" type="checkbox"/> Cable tool _____ Rotary _____ Driven _____ Dug <b>Drive Core</b>		
			<input type="checkbox"/> Hollow rod _____ Jetted _____ Bored _____ Reverse rotary		
			8. Use: <input checked="" type="checkbox"/> Domestic _____ Public supply _____ Industry _____ Irrigation _____ Air conditioning _____ Stock _____ Lawn _____ Oil field water _____ Other _____		
			9. Casing: Material <b>PITS</b> Height: <b>Above or below</b>		
			Threaded _____ Welded _____ Surface <b>21</b> in.		
			RMP <input checked="" type="checkbox"/> PVC _____ Weight _____ lbs./ft.		
			Dia. <b>5</b> in. to <b>56</b> ft. depth	Wall Thickness: inches or	
			Dia. _____ in. to _____ ft. depth	gage No. <b>200</b>	
5. Type and color of material	From	To	10. Screen: Manufacturer's name <b>Sueflower</b>		
<b>Top Soil</b>	<b>0</b>	<b>3</b>	Type _____ Dia. <b>5 1/2"</b>		
<b>Sandy Loam</b>	<b>3</b>	<b>25</b>	Slot/gauze <b>.050</b> Length <b>10'</b>		
<b>Sand Fine Brown</b>	<b>25</b>	<b>30</b>	Set between <b>4 1/2</b> ft. and <b>56</b> ft.		
<b>Sand grey F-med. Clay</b>	<b>30</b>	<b>38</b>	_____ ft. and _____ ft.		
<b>Sand &amp; clay</b>	<b>40</b>	<b>43</b>	Gravel pack? <b>No</b> Size range of material _____		
<b>Sand med dirty</b>	<b>43</b>	<b>45</b>	11. Static water level: _____ mo./day/yr.		
<b>Sand med-coarse</b>	<b>45</b>	<b>56</b>	<b>19</b> ft. below land surface Date <b>4-23-78</b>		
<b>Not on Bottom</b>			12. Pumping level below land surfaces:		
			_____ ft. after _____ hrs. pumping _____ g.p.m.		
			_____ ft. after _____ hrs. pumping _____ g.p.m.		
			Estimated maximum yield <b>85 +</b> g.p.m.		
			13. Water sample submitted: _____ mo./day/yr.		
			<input type="checkbox"/> Yes <input checked="" type="checkbox"/> No Date _____		
			14. Well head completion:		
			<input type="checkbox"/> Pitless adapter <b>24"</b> Inches above grade		
			15. Well grouted? <b>yes</b>		
			With: <input checked="" type="checkbox"/> Neat cement _____ Bentonite _____ Concrete		
			Depth: From <b>0</b> ft. to <b>19</b> ft.		
			16. Nearest source of possible contamination:		
			ft. <b>100'</b> Direction <b>North</b> Type <b>Septic</b>		
			Well disinfected upon completion? <input checked="" type="checkbox"/> Yes _____ No		
			17. Pump: <input checked="" type="checkbox"/> Not installed		
			Manufacturer's name _____		
			Model number _____ HP _____ Volts _____		
			Length of drop pipe _____ ft. capacity _____ g.p.m.		
			Type: _____ Submersible _____ Turbine _____ Jet _____ Reciprocating _____ Centrifugal _____ Other _____		
18. Elevation: <b>847</b>	19. Remarks: <b>owner to install slab.</b>		20. Water well contractor's certification:		
Topography: _____ Hill _____ Slope _____ Upland _____ Valley <input checked="" type="checkbox"/>			This well was drilled under my jurisdiction and this report is true to the best of my knowledge and belief.		
			<b>Robison Drilling 316</b>		
			Business name _____ License No. _____		
			Address <b>Perry KS</b>		
			Signed <b>Jack Robison</b> Date <b>4-23-78</b>		
			Authorized representative		

T 11 R 18 W 26 NE SE

BR 6791