


1 LOCATION OF WATER WELL: County: **Jefferson** Distance and direction from nearest town or city street address of well if located within city? **Front Street, Perry, Kansas**

2 WATER WELL OWNER: RR#, St. Address, Box #: **White Cloud Grain Box 276, Hiawatha, Ks 66434** Board of Agriculture, Division of Water Resources City, State, ZIP Code: **Attn: Warren Beavers**

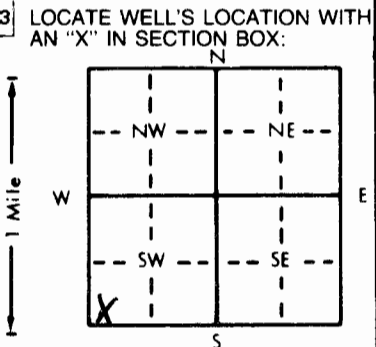

4 DEPTH OF COMPLETED WELL: **30** ft. ELEVATION: **847.42**

Depth(s) Groundwater Encountered 1. **23.3** ft. 2. **—** ft. 3. **—** ft.

WELL'S STATIC WATER LEVEL: **21.16** ft. below land surface measured on mo/day/yr **1-26-95**

Pump test data: Well water was **—** ft. after **—** hours pumping **—** gpm

Est. Yield **—** gpm Well water was **—** ft. after **—** hours pumping **—** gpm

Bore Hole Diameter: **8.625** in. to **30** ft., and **—** in. to **—** ft.

WELL WATER TO BE USED AS:

- 5 Public water supply
- 8 Air conditioning
- 11 Injection well
- 1 Domestic
- 3 Feedlot
- 6 Oil field water supply
- 9 Dewatering
- 12 Other (Specify below)
- 2 Irrigation
- 4 Industrial
- 7 Lawn and garden only
- 10 Monitoring well **mw-9**

Was a chemical/bacteriological sample submitted to Department? Yes **—** No **X** If yes, mo/day/yr sample was submitted **—**

Water Well Disinfected? Yes **—** No **X**

5 TYPE OF BLANK CASING USED:

- 1 Steel
- 2 PVC
- 3 RMP (SR)
- 4 ABS
- 5 Wrought iron
- 6 Asbestos-Cement
- 7 Fiberglass
- 8 Concrete tile
- 9 Other (specify below)

CASING JOINTS: Glued **—** Clamped **—** Welded **—** Threaded **X**

Blank casing diameter: **2** in. to **20** ft., Dia. **—** in. to **—** ft., Dia. **—** in. to **—** ft.

Casing height above land surface: **0** in., weight **sch. 40 pvc** lbs./ft. Wall thickness or gauge No. **—**

TYPE OF SCREEN OR PERFORATION MATERIAL:

- 1 Steel
- 2 Brass
- 3 Stainless steel
- 4 Galvanized steel
- 5 Fiberglass
- 6 Concrete tile
- 7 PVC
- 8 RMP (SR)
- 9 ABS
- 10 Asbestos-cement
- 11 Other (specify)
- 12 None used (open hole)

SCREEN OR PERFORATION OPENINGS ARE:

- 1 Continuous slot
- 2 Louvered shutter
- 3 Mill slot
- 4 Key punched
- 5 Gauzed wrapped
- 6 Wire wrapped
- 7 Torch cut
- 8 Saw cut
- 9 Drilled holes
- 10 Other (specify)
- 11 None (open hole)

SCREEN-PERFORATED INTERVALS: From **20** ft. to **30** ft., From **—** ft. to **—** ft., From **—** ft. to **—** ft., From **—** ft. to **—** ft.

SAND GRAVEL PACK INTERVALS: From **19** ft. to **30** ft., From **—** ft. to **—** ft., From **—** ft. to **—** ft., From **—** ft. to **—** ft.

6 GROUT MATERIAL:

- 1 Neat cement
- 2 Cement grout
- 3 Bentonite
- 4 Other

Grout Intervals: From **0** ft. to **17** ft., From **17** ft. to **19** ft., From **—** ft. to **—** ft., From **—** ft. to **—** ft.

What is the nearest source of possible contamination:

- 1 Septic tank
- 2 Sewer lines
- 3 Watertight sewer lines
- 4 Lateral lines
- 5 Cess pool
- 6 Seepage pit
- 7 Pit privy
- 8 Sewage lagoon
- 9 Feedyard
- 10 Livestock pens
- 11 Fuel storage
- 12 Fertilizer storage
- 13 Insecticide storage
- 14 Abandoned water well
- 15 Oil well/Gas well
- 16 Other (specify below) **contaminated site**

Direction from well? **How many feet?**

FROM	TO	LITHOLOGIC LOG	FROM	TO	PLUGGING INTERVALS
GL	3.0	Fill			Flush Mount Waiver Don Taylor 1/12/95
3.0	6.5	Silty Clay			
6.5	8.0	Clayey Silt			
8.0	18.0	Silty Sand			
18.0	30.0	Clayey Silt			
30.0	TD	END OF BOREHOLE			

7 CONTRACTOR'S OR LANDOWNER'S CERTIFICATION: This water well was (1) constructed, (2) reconstructed, or (3) plugged under my jurisdiction and was completed on (mo/day/year) **1-26-95** and this record is true to the best of my knowledge and belief. Kansas Water Well Contractor's License No. **585** This Water Well Record was completed on (mo/day/yr) **2-21-95** under the business name of **Associated Environmental, Inc** by (signature) **D. Johnson for Dawn Duncan**