


1 LOCATION OF WATER WELL: Fraction SE 1/4 NW 1/4 SE 1/4 Section Number 26 Township Number T 11 S Range Number R 18 E

Distance and direction from nearest town or city street address of well if located within city?
3/4 south, 3/8 east of Perry

2 WATER WELL OWNER: Daryl Mellard
 RR#, St. Address, Box # : Rt. 1 Box 191 Board of Agriculture, Division of Water Resources
 City, State, ZIP Code : Perry, KS 66073 Application Number: 41534

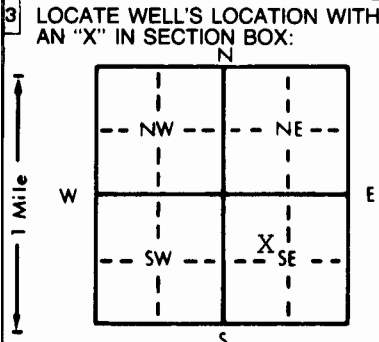

4 DEPTH OF COMPLETED WELL: 62' ft. ELEVATION:
 Depth(s) Groundwater Encountered 1. ft. 2. ft. 3. ft.
 WELL'S STATIC WATER LEVEL .14' ft. below land surface measured on mo/day/yr 3-24-95
 Pump test data: Well water was ft. after hours pumping gpm
 Est. Yield .200. gpm: Well water was ft. after hours pumping gpm
 Bore Hole Diameter .12" in. to ft., and in. to ft.
 WELL WATER TO BE USED AS:
 5 Public water supply 8 Air conditioning 11 Injection well
 1 Domestic 3 Feedlot 6 Oil field water supply 9 Dewatering 12 Other (Specify below)
 2 Irrigation 4 Industrial 7 Lawn and garden only 10 Monitoring well
 Was a chemical/bacteriological sample submitted to Department? Yes No X If yes, mo/day/yr sample was submitted
 Water Well Disinfected? Yes X No

5 TYPE OF BLANK CASING USED:
 1 Steel 3 RMP (SR) 5 Wrought iron 8 Concrete tile CASING JOINTS: Glued X Clamped
 2 PVC 4 ABS 6 Asbestos-Cement 9 Other (specify below) Welded
 7 Fiberglass Threaded
 Blank casing diameter 6" in. to 0-52 ft., Dia in. to ft., Dia in. to ft.
 Casing height above land surface 24" in., weight 3.6 lbs./ft. Wall thickness or gauge No. 280
 TYPE OF SCREEN OR PERFORATION MATERIAL: JOHNSON 7 PVC 10 Asbestos-cement
 1 Steel 3 Stainless steel 5 Fiberglass 8 RMP (SR) 11 Other (specify)
 2 Brass 4 Galvanized steel 6 Concrete tile 9 ABS 12 None used (open hole)
 SCREEN OR PERFORATION OPENINGS ARE:
 5 Gauzed wrapped 8 Saw cut 11 None (open hole)
 1 Continuous slot 3 Mill slot 6 Wire wrapped 9 Drilled holes
 2 Louvered shutter 4 Key punched 7 Torch cut 10 Other (specify)
 SCREEN-PERFORATED INTERVALS: From 52 ft. to 62 ft., From ft. to ft.
 From ft. to ft., From ft. to ft.
 GRAVEL PACK INTERVALS: From 24 ft. to 62 ft., From ft. to ft.
 From ft. to ft., From ft. to ft.

6 GROUT MATERIAL: 1 Neat cement 2 Cement grout 3 Bentonite 4 Other
 Grout Intervals: From 4 ft. to 24 ft., From ft. to ft., From ft. to ft.
 What is the nearest source of possible contamination:
 1 Septic tank 4 Lateral lines 7 Pit privy 10 Livestock pens 14 Abandoned water well
 2 Sewer lines 5 Cess pool 8 Sewage lagoon 11 Fuel storage 15 Oil well/Gas well
 3 Watertight sewer lines 6 Seepage pit 9 Feedyard 12 Fertilizer storage 16 Other (specify below)
 13 Insecticide storage 310' pond
 Direction from well? north How many feet?

FROM	TO	LITHOLOGIC LOG	FROM	TO	PLUGGING INTERVALS
0	6	Top Soil			
6	20	Clay-Brown-Silty			
20	24	Clay-Blue			
24	30	FS-cs-Med-Pea Gravel-Blue/Br			
30	33	Clay-Blue			
33	45	FS-Cs-Med-Pea-Br, Blue			
45	55	FS-CS-MED-Pea 1/2x3/8			
55	62	FS-CS-Med-Pea 1/4x3/4			
62	65	Gr. Limestone			

7 CONTRACTOR'S OR LANDOWNER'S CERTIFICATION: This water well was (1) constructed, (2) reconstructed, or (3) plugged under my jurisdiction and was completed on (mo/day/year) 3-24-95 and this record is true to the best of my knowledge and belief. Kansas Water Well Contractor's License No. 182 This Water Well Record was completed on (mo/day/yr) 3-26-95 under the business name of STRADER DRILLING CO., INC. by (signature) Dale Skerem