


1 LOCATION OF WATER WELL: Fraction SE 1/4 SE 1/4 SW 1/4 Section Number 17 Township Number T 11 S Range Number R 19 E/W
 County: JEFFERSON

Distance and direction from nearest town or city street address of well if located within city?
1 1/2 Miles NORTH 1/8 Mile WEST OF WILLIAM TOWN

2 WATER WELL OWNER: TOM & KAREN LOCKE
 RR#, St. Address, Box #: 2523 ARKANSAS
 City, State, ZIP Code: LAURENCE, KS
 Board of Agriculture, Division of Water Resources
 Application Number:

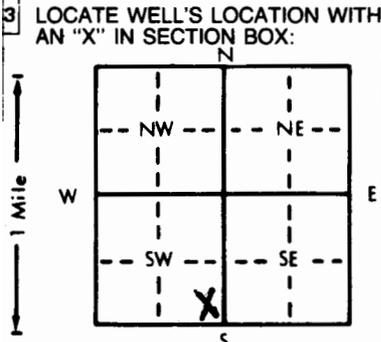

4 DEPTH OF COMPLETED WELL: 44 ft. ELEVATION:
 Depth(s) Groundwater Encountered 1. 4 ft. 2. 40 ft. 3. .ft.
 WELL'S STATIC WATER LEVEL: 22 ft. below land surface measured on mo/day/yr 6-23-92
 Pump test data: Well water was .ft. after . hours pumping . gpm
 Est. Yield 20 gpm: Well water was .ft. after . hours pumping . gpm
 Bore Hole Diameter: 8 in. to 44 ft., and . in. to .ft.
 WELL WATER TO BE USED AS:
 Domestic 3 Feedlot 6 Oil field water supply 9 Dewatering 12 Other (Specify below)
 2 Irrigation 4 Industrial 7 Lawn and garden only 10 Monitoring well
 Was a chemical/bacteriological sample submitted to Department? Yes No ; If yes, mo/day/yr sample was submitted 6-25-92
 Water Well Disinfected? Yes No

5 TYPE OF BLANK CASING USED:
 1 Steel 3 RMP (SR) 5 Wrought iron 8 Concrete tile CASING JOINTS: Glued Clamped
 PVC 4 ABS 6 Asbestos-Cement 9 Other (specify below) Welded
 7 Fiberglass Threaded
 Blank casing diameter: 5 in. to 34 ft., Dia. . in. to .ft., Dia. . in. to .ft.
 Casing height above land surface: 36" in., weight . lbs./ft. Wall thickness or gauge No. SDR-26
 TYPE OF SCREEN OR PERFORATION MATERIAL:
 PVC 10 Asbestos-cement
 1 Steel 3 Stainless steel 5 Fiberglass 8 RMP (SR) 11 Other (specify) .
 2 Brass 4 Galvanized steel 6 Concrete tile 9 ABS 12 None used (open hole)
 SCREEN OR PERFORATION OPENINGS ARE:
 1 Continuous slot Mill slot 5 Gauzed wrapped 8 Saw cut 11 None (open hole)
 2 Louvered shutter 4 Key punched 6 Wire wrapped 9 Drilled holes
 7 Torch cut 10 Other (specify) .
 SCREEN-PERFORATED INTERVALS: From 34 ft. to 44 ft., From .ft. to .ft.
 From .ft. to .ft., From .ft. to .ft.
 GRAVEL PACK INTERVALS: From 27 ft. to 44 ft., From .ft. to .ft.
 From .ft. to .ft., From .ft. to .ft.

6 GROUT MATERIAL: 1 Neat cement 2 Cement grout Bentonite 4 Other .
 Grout Intervals: From 0 ft. to 27 ft., From .ft. to .ft., From .ft. to .ft.
 What is the nearest source of possible contamination:
 Septic tank 4 Lateral lines 7 Pit privy 10 Livestock pens 14 Abandoned water well
 Sewer lines 5 Cess pool 8 Sewage lagoon 11 Fuel storage 15 Oil well/Gas well
 3 Watertight sewer lines 6 Seepage pit 9 Feedyard 12 Fertilizer storage 16 Other (specify below)
 13 Insecticide storage
 Direction from well? NORTH How many feet? 400

FROM	TO	LITHOLOGIC LOG	FROM	TO	PLUGGING INTERVALS
0	3	SOIL			
3	25	CLAY GUMBO			
25	40	SANDY CLAY			
40	42	SAND & GRAVEL			
42	44	GREY SHALE			

7 CONTRACTOR'S OR LANDOWNER'S CERTIFICATION: This water well was constructed, reconstructed, or plugged under my jurisdiction and was completed on (mo/day/year) 7-1-92 and this record is true to the best of my knowledge and belief. Kansas Water Well Contractor's License No. 536 This Water Well Record was completed on (mo/day/yr) 7-1-92 under the business name of PATCHEN Pump & Well Drilling Inc by (signature) Tom P. Patchen Jr

OFFICE USE ONLY

T

R

EM

SEC.

1/4

1/4

1/4

1/4

1/4