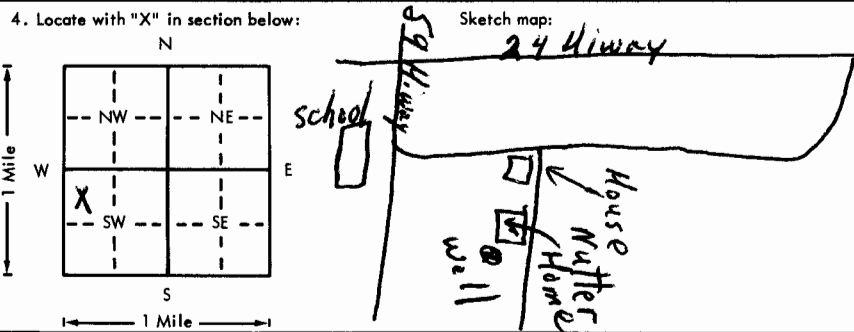


USE TYPEWRITER OR BALL
POINT PEN-PRESS FIRMLY,
PRINT CLEARLY.

WATER WELL RECORD
KSA 82a-1201-1215

Kansas Department of Health and
Environment-Division of Environment
(Water well Contractors)
Topeka, Kansas 66620

1. Location of well:	County <u>Jefferson</u>	Fraction <u>SE 1/4 NW 1/4 SW 1/4</u>	Section number <u>29</u>	Township number <u>T 11 S</u>	Range number <u>R 19 E</u>
2. Distance and direction from nearest town or city: <u>Well Located in Williamstown</u>			3. Owner of well: <u>Russel Nutter</u> R.R. or street: <u>RR #1 Perry Kans 66073</u> City, state, zip code:		
4. Locate with "X" in section below: 			6. Bore hole dia. <u>6 1/2</u> in. Completion date <u>Nov 23-76</u> Well depth <u>64</u> ft.		
5. Type and color of material			7. <input checked="" type="checkbox"/> Cable tool <input type="checkbox"/> Rotary <input type="checkbox"/> Driven <input type="checkbox"/> Dig <input type="checkbox"/> Hollow rod <input type="checkbox"/> Jetted <input type="checkbox"/> Bored <input type="checkbox"/> Reverse rotary		
			8. Use: <input checked="" type="checkbox"/> Domestic <input type="checkbox"/> Public supply <input type="checkbox"/> Industry <input type="checkbox"/> Irrigation <input type="checkbox"/> Air conditioning <input type="checkbox"/> Stock <input type="checkbox"/> Lawn <input type="checkbox"/> Oil field water <input type="checkbox"/> Other		
			9. Casing: Material <u>PITS</u> Height: Above or below Threaded <input type="checkbox"/> Welded <input type="checkbox"/> Surface <u>18</u> in. RMP <input checked="" type="checkbox"/> PVC <input type="checkbox"/> Weight <input type="checkbox"/> lbs./ft. Dia. <u>5</u> in. to <u>64</u> ft. depth Wall Thickness: inches or Dia. <input type="checkbox"/> in. to <input type="checkbox"/> ft. depth gage No. <u>200</u>		
			10. Screen: Manufacturer's name <u>Sun Flower</u> Type <u>RMP</u> Dia. <u>5"</u> Slot/gauze <u>1/16</u> Length <u>7'</u> Set between <u>57</u> ft. and <u>64</u> ft. Gravel pack? <u>no</u> Size range of material		
			11. Static water level: <u>31</u> ft. below land surface Date <u>Nov 23-76</u> mo./day/yr.		
(Use a second sheet if needed)			12. Pumping level below land surfaces: ____ ft. after ____ hrs. pumping ____ g.p.m. ____ ft. after ____ hrs. pumping ____ g.p.m. Estimated maximum yield <u>24+</u> g.p.m.		
			13. Water sample submitted: <u>no</u> mo./day/yr. Yes <input checked="" type="checkbox"/> No <input type="checkbox"/> Date		
			14. Well head completion: ____ Pitless adapter <u>12</u> inches above grade		
			15. Well grouted? <u>yes</u> With: <input checked="" type="checkbox"/> Neat cement <input type="checkbox"/> Bentonite <input type="checkbox"/> Concrete Depth: From <u>3</u> ft. to <u>20</u> ft.		
			16. Nearest source of possible contamination: ft. <u>50+</u> Direction <u>NW</u> Type <u>Septic</u> Well disinfected upon completion? <input checked="" type="checkbox"/> Yes <input type="checkbox"/> No		
			17. Pump: <input checked="" type="checkbox"/> Not installed Manufacturer's name Model number ____ HP ____ Volts ____ Length of drop pipe ____ ft. capacity ____ g.p.m. Type: <input type="checkbox"/> Submersible <input type="checkbox"/> Turbine <input type="checkbox"/> Jet <input type="checkbox"/> Reciprocating <input type="checkbox"/> Centrifugal <input type="checkbox"/> Other		
			18. Elevation: <u>3</u> <u>855</u> Topography: <input type="checkbox"/> Hill <input type="checkbox"/> Slope <input type="checkbox"/> Upland <input checked="" type="checkbox"/> Valley		
			19. Remarks: <u>owner to install slab.</u>		
			20. Water well contractor's certification: This well was drilled under my jurisdiction and this report is true to the best of my knowledge and belief. <u>Robison Drilling</u> 316 Business name License No. Address <u>Perry Ks.</u> Signed <u>Jack Robison</u> Date <u>12-7-76</u> Authorized representative		

Forward the white, blue and pink copies to the Department of Health and Environment

Form WWC-5

BR elev = 796 789

▽ = 824 822