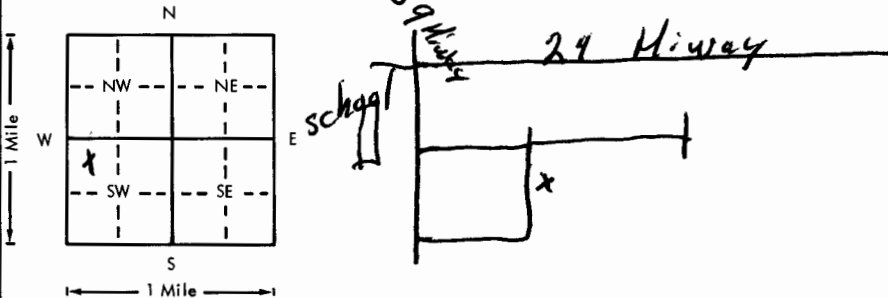


37  
USE TYPEWRITER OR BALL  
POINT PEN-PRESS FIRMLY,  
PRINT CLEARLY.

WATER WELL RECORD  
KSA 82a-1201-1215

Kansas Department of Health and  
Environment-Division of Environment  
(Water well Contractors)  
Topeka, Kansas 66620

Lot 5-6-7 Block 8 Williamsstown

1. Location of well:	County <b>Jeff</b>	Fraction <b>C 1/4 NW 1/4 SE 1/4</b>	Section number <b>29</b>	Township number <b>T 11 S</b>	Range number <b>R 19 E</b>
2. Distance and direction from nearest town or city: Street address of well location if in city:		3. Owner of well: R.R. or street: City, state, zip code:			
<b>Well located in Williamsstown.</b>		<b>Daryl Pickens</b> <b>RT 1 Box 116</b> <b>Perry Ks. 66073</b>			
4. Locate with "X" in section below:		Sketch map:		6. Bore hole dia. <b>6 3/4</b> in. Completion date <b>4-25-77</b> Well depth <b>63</b> ft.	
				7. <input checked="" type="checkbox"/> Cable tool <input type="checkbox"/> Rotary <input type="checkbox"/> Driven <input type="checkbox"/> Dug <input type="checkbox"/> Hollow rod <input type="checkbox"/> Jetted <input type="checkbox"/> Bored <input type="checkbox"/> Reverse rotary	
5. Type and color of material		From	To	8. Use: <input checked="" type="checkbox"/> Domestic <input type="checkbox"/> Public supply <input type="checkbox"/> Industry <input type="checkbox"/> Irrigation <input type="checkbox"/> Air conditioning <input type="checkbox"/> Stock <input type="checkbox"/> Lawn <input type="checkbox"/> Oil field water <input type="checkbox"/> Other	
<b>Top Soil</b>		<b>0</b>	<b>5</b>	9. Casing: Material <b>PFS</b> Height: Above or below Threaded <input type="checkbox"/> Welded <input type="checkbox"/> Surface <b>12</b> in. RMP <input checked="" type="checkbox"/> PVC <input type="checkbox"/> Weight <input type="checkbox"/> lbs./ft. Dia. <b>5</b> in. to <b>63</b> ft. depth Wall Thickness: inches or Dia. <input type="checkbox"/> in. to <input type="checkbox"/> ft. depth gage No. <b>200</b>	
<b>Loamy Clay</b>		<b>5</b>	<b>17</b>	10. Screen: Manufacturer's name <b>Sunflower</b> Type <b>RMP</b> Dia. <b>5"</b> Slot/gauze <b>1/16</b> Length <b>5'</b> Set between <b>5'</b> ft. and <b>63</b> ft. <input type="checkbox"/> ft. and <input type="checkbox"/> ft. Gravel pack? <b>No</b> Size range of material <input type="checkbox"/>	
<b>Clay sandy in spots</b>		<b>17</b>	<b>50</b>	11. Static water level: <input type="checkbox"/> mo./day/yr. <b>30</b> ft. below land surface Date <b>4-25-77</b>	
<b>Sand dirty med</b>		<b>50</b>	<b>57</b>	12. Pumping level below land surfaces: <input type="checkbox"/> ft. after <input type="checkbox"/> hrs. pumping <input type="checkbox"/> g.p.m. <input type="checkbox"/> ft. after <input type="checkbox"/> hrs. pumping <input type="checkbox"/> g.p.m. Estimated maximum yield <b>12+</b> g.p.m.	
<b>Sand med-coarse</b>		<b>57</b>	<b>63</b>	13. Water sample submitted: <input type="checkbox"/> mo./day/yr. <input type="checkbox"/> Yes <input checked="" type="checkbox"/> No Date <input type="checkbox"/>	
				14. Well head completion: <input type="checkbox"/> Pitless adapter <b>12</b> Inches above grade	
				15. Well grouted? <b>yes</b> With: <input checked="" type="checkbox"/> Neat cement <input type="checkbox"/> Bentonite <input type="checkbox"/> Concrete Depth: From <b>0</b> ft. to <b>14</b> ft.	
				16. Nearest source of possible contamination: ft. <b>50+</b> Direction <b>S.E.</b> Type <b>Septic</b> Well disinfected upon completion? <input checked="" type="checkbox"/> Yes <input type="checkbox"/> No	
				17. Pump: <input checked="" type="checkbox"/> Not installed Manufacturer's name <input type="checkbox"/> Model number <input type="checkbox"/> HP <input type="checkbox"/> Volts <input type="checkbox"/> Length of drop pipe <input type="checkbox"/> ft. capacity <input type="checkbox"/> g.p.m. Type: <input type="checkbox"/> Submersible <input type="checkbox"/> Turbine <input type="checkbox"/> Jet <input type="checkbox"/> Reciprocating <input type="checkbox"/> Centrifugal <input type="checkbox"/> Other	
18. Elevation: <b>854</b> Topography: <input type="checkbox"/> Hill <input type="checkbox"/> Slope <input type="checkbox"/> Upland <input checked="" type="checkbox"/> Valley		19. Remarks: <b>owner to install slab</b>		20. Water well contractor's certification: This well was drilled under my jurisdiction and this report is true to the best of my knowledge and belief. <b>Robison Drilling 316</b> Business name <b>Perry Ks</b> License No. <input type="checkbox"/> Address <b>Perry Ks</b> Signed <b>Jack Robison</b> Date <b>4-29-77</b> Authorized representative	

Forward the white, blue and pink copies to the Department of Health and Environment

Form WWC-5