


1	LOCATION OF WATER WELL:	Fraction	Section Number	Township Number	Range Number
	County: JEFFERSON	NW ¼ NW ¼ SW ¼	29	T 11 S	R 19 EW

Distance and direction from nearest town or city street address of well if located within city?

In Williamstown		
2	WATER WELL OWNER: M.C. Leonard	
	RR#, St. Address, Box # : P.O. Box 662	Board of Agriculture, Division of Water Resource
	City, State, ZIP Code : Perry, KS 66073	Application Number:

LOCATE WELL'S LOCATION WITH AN "X" IN SECTION BOX: 4. DEPTH OF COMPLETED WELL: 60 ft. ELEVATION: .
Depth(s) Groundwater Encountered 1. . ft. 2. . ft. 3. . ft.

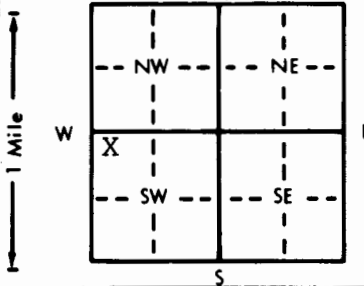

4 DEPTH OF COMPLETED WELL..... 60 ft. ELEVATION:
 Depth(s) Groundwater Encountered 1. ft. 2. ft. 3. ft.
 WELL'S STATIC WATER LEVEL . 30' ft. below land surface measured on mo/day/yr .. 10-26-89
 Pump test data: Well water was ft. after hours pumping gpm
 Est. Yield . 50. gpm: Well water was ft. after hours pumping gpm
 Bore Hole Diameter. . 12" in. to ft., and in. to ft.
 WELL WATER TO BE USED AS: 5 Public water supply 8 Air conditioning 11 Injection well
 1 Domestic 3 Feedlot 6 Oil field water supply 9 Dewatering 12 Other (Specify below)
 2 Irrigation 4 Industrial 7 Lawn and garden only 10 Monitoring well
 Was a chemical/bacteriological sample submitted to Department? Yes.....No.....X.....; If yes, mo/day/yr sample was sub
 mitted Water Well Disinfected? Yes X No

5	TYPE OF BLANK CASING USED:		5 Wrought iron	8 Concrete tile	CASING JOINTS: Glued . . ☒ . . Clamped Welded Threaded
	1 Steel	3 RMP (SR)	6 Asbestos-Cement	9 Other (specify below)	
	2 PVC	4 ABS	7 Fiberglass		

Blank casing diameter 5" . . . in. to 0-50 . . . ft. Dia . . . in. to . . . ft. Dia . . . in. to . . . ft.
Casing height above land surface 24" . . . in. weight . . . 2.82 . . . lbs./ft. Wall thickness or gauge No. . . . 258

TYPE OF SCREEN OR PERFORATION MATERIAL:			<u>7 PVC</u>	10 Asbestos-cement
1 Steel	3 Stainless steel	5 Fiberglass	8 RMP (SR)	11 Other (specify)
2 Brass	4 Galvanized steel	6 Concrete tile	9 ABS	12 None used (open hole)

SCREEN OR PERFORATION OPENINGS ARE:

1 Continuous slot	3 Mill slot	5 Gauzed wrapped	8 Saw cut	11 None (open hole)
2 Louvered shutter	4 Key punched	6 Wire wrapped	9 Drilled holes	
		7 Torch cut	10 Other (specify)	

SCREEN-PERFORATED INTERVALS:	From . . . 50 ft. to 60 ft.,	From ft. to ft.
	From ft. to ft.,	From ft. to ft.
GRAVEL PACK INTERVALS:	From . . . 24 ft. to 60 ft.,	From ft. to ft.
	From ft. to ft.,	From ft. to ft.

6) GROUT MATERIAL: 1 Neat cement 2 Cement grout 3 Bentonite 4 Other Hole plug
Grout Intervals: From 4 ft. to 24 ft., From _____ ft. to _____ ft., From _____ ft. to _____ ft.

What is the nearest source of possible contamination:			10 Livestock pens	14 Abandoned water well
1 Septic tank	4 Lateral lines	7 Pit privy	11 Fuel storage	15 Oil well/Gas well
2 Sewer lines	5 Cess pool	8 Sewage lagoon	12 Fertilizer storage	16 Other (specify below)
3 Watertight sewer lines	6 Seepage pit	9 Feedyard	13 Insecticide storage	
Direction from well?	East		How many feet?	120'

[illegible]

7 CONTRACTOR'S OR LANDOWNER'S CERTIFICATION: This water well was (1) constructed, (2) reconstructed, or (3) plugged under my jurisdiction and was completed on (mo/day/year) . . . 10-26-89 and this record is true to the best of my knowledge and belief. Kansas Water Well Contractor's License No. . . 182 This Water Well Record was completed on (mo/day/yr) . . 11-15-89 under the business name of STRADER DRILLING CO., INC. by (signature) *Steve Strader*