


1 LOCATION OF WATER WELL: County: **JEFFERSON** Fraction: **NW 1/4 NW 1/4 NW 1/4** Section Number: **32** Township Number: **T 11 S** Range Number: **R 19 E**

Distance and direction from nearest town or city street address of well if located within city:

**1 MILE SOUTH OF WILLIAM TOWN**

2 WATER WELL OWNER: **RITA DECOURSEY**  
 RR#, St. Address, Box #: **91 FRANK MARTIN**  
 City, State, ZIP Code: **PO BOX 1220 KANSAS CITY, KS 66117**  
 Board of Agriculture, Division of Water Resources  
 Application Number:

3 LOCATE WELL'S LOCATION WITH AN "X" IN SECTION BOX: 4 DEPTH OF COMPLETED WELL: **29** ft. ELEVATION:

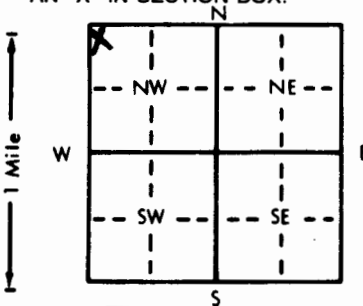

Depth(s) Groundwater Encountered 1. . . . . ft. 2. . . . . ft. 3. . . . . ft.

WELL'S STATIC WATER LEVEL **21** ft. below land surface measured on mo/day/yr

Pump test data: Well water was . . . . . ft. after . . . . . hours pumping . . . . . gpm

Est. Yield . . . . . gpm: Well water was . . . . . ft. after . . . . . hours pumping . . . . . gpm

Bore Hole Diameter . . . . . in. to . . . . . ft., and . . . . . in. to . . . . . ft.

WELL WATER TO BE USED AS: 5 Public water supply 8 Air conditioning 11 Injection well

☒ 1 Domestic 3 Feedlot 6 Oil field water supply 9 Dewatering 12 Other (Specify below)

2 Irrigation 4 Industrial 7 Lawn and garden only 10 Monitoring well

Was a chemical/bacteriological sample submitted to Department? Yes . . . . . No ☒ . . . . . If yes, mo/day/yr sample was submitted

Water Well Disinfected? Yes ☒ No

5 TYPE OF BLANK CASING USED: 5 Wrought iron 8 Concrete tile CASING JOINTS: Glued . . . . . Clamped . . . . .

1 Steel 3 RMP (SR) 6 Asbestos-Cement 9 Other (specify below) Welded . . . . .

☒ 2 PVC 4 ABS 7 Fiberglass Threaded . . . . .

Blank casing diameter **5** in. to . . . . . ft., Dia . . . . . in. to . . . . . ft., Dia . . . . . in. to . . . . . ft.

Casing height ~~above~~ land surface: **36' BELOW** in., weight . . . . . lbs./ft. Wall thickness or gauge No. . . . .

TYPE OF SCREEN OR PERFORATION MATERIAL: 7 PVC 10 Asbestos-cement

1 Steel 3 Stainless steel 5 Fiberglass 8 RMP (SR) 11 Other (specify) **NA**

2 Brass 4 Galvanized steel 6 Concrete tile 9 ABS 12 None used (open hole)

SCREEN OR PERFORATION OPENINGS ARE: 5 Gauzed wrapped 8 Saw cut 11 None (open hole)

1 Continuous slot 3 Mill slot 6 Wire wrapped 9 Drilled holes **NA**

2 Louvered shutter 4 Key punched 7 Torch cut 10 Other (specify) **NA**

SCREEN-PERFORATED INTERVALS: From . . . . . ft. to . . . . . ft., From . . . . . ft. to . . . . . ft.

From . . . . . ft. to . . . . . ft., From . . . . . ft. to . . . . . ft.

GRAVEL PACK INTERVALS: From . . . . . ft. to . . . . . ft., From . . . . . ft. to . . . . . ft.

From . . . . . ft. to . . . . . ft., From . . . . . ft. to . . . . . ft.

6 GROUT MATERIAL: ☒ 1 Neat cement 2 Cement grout 3 Bentonite 4 Other . . . . .

Grout Intervals: From **29** ft. to **3** ft., From . . . . . ft. to . . . . . ft., From . . . . . ft. to . . . . . ft.

What is the nearest source of possible contamination: 10 Livestock pens 14 Abandoned water well

1 Septic tank ☒ 4 Lateral lines 7 Pit privy 11 Fuel storage 15 Oil well/Gas well

2 Sewer lines 5 Cess pool 8 Sewage lagoon 12 Fertilizer storage 16 Other (specify below)

3 Watertight sewer lines 6 Seepage pit 9 Feedyard 13 Insecticide storage

Direction from well? **WEST** How many feet? **100**

FROM TO LITHOLOGIC LOG FROM TO PLUGGING INTERVALS

0 3 SOIL  
3 29 NEAT CEMENT

Old well about 50ft NW from new well not properly plugged

7 CONTRACTOR'S OR LANDOWNER'S CERTIFICATION: This water well was (1) constructed, (2) reconstructed, or (3) plugged under my jurisdiction and was

completed on (mo/day/year) **8/23/91** and this record is true to the best of my knowledge and belief. Kansas

Water Well Contractor's License No. **536** This Water Well Record was completed on (mo/day/yr) **8/27/91**

under the business name of **Patchen Pump & Well Drilling Inc** by (signature) **Jim Patchen**