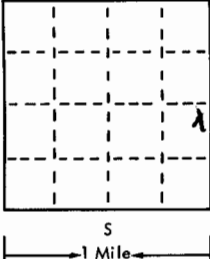
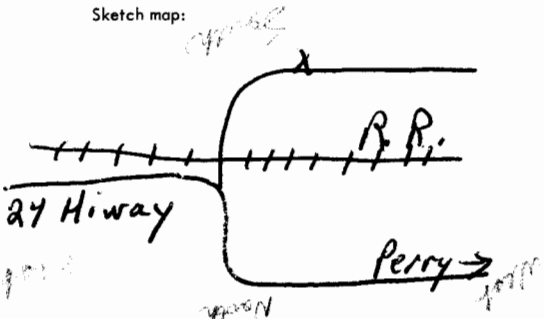


USE TYPEWRITER OR BALL
POINT PEN-PRESS FIRMLY,
PRINT CLEARLY.

WATER WELL RECORD
KSA 82a-1201-1215

T R EW sec 1/4 1/4 1/4 No.

Kansas State Dept. Of Health
(Water Well Contractors)
Forbes-Bldg. 740
Topeka, Kansas 66620

1 Location of well:	County: <u>Jefferson</u>	Township name: <u>Rural</u>	Fraction: <u>NE 1/4 SE 1/4</u>	Section number: <u>33</u>	Town number: <u>115</u>	Range number: <u>19E</u>	
Distance and direction from nearest town or city: <u>5 mi East of Perry</u>				3 Owner of well: <u>George Gentz</u>			
Street address of well location if in city:				Address: <u>Perry Kansas.</u>			
Locate with "X" in section below: N 		Sketch map: 		4 Well depth: <u>57</u> ft. Date of completion: <u>12-22-75</u> Well diameter <u>5</u> in.			
2		Type and color of material		From To		5 <input checked="" type="checkbox"/> Cable tool <input type="checkbox"/> Rotary <input type="checkbox"/> Driven <input type="checkbox"/> Dug <input type="checkbox"/> Hollow rod <input type="checkbox"/> Jetted <input type="checkbox"/> Bored <input type="checkbox"/> Reverse rotary	
						6 Use: <input checked="" type="checkbox"/> Domestic <input type="checkbox"/> Public supply <input type="checkbox"/> Industry <input type="checkbox"/> Irrigation <input type="checkbox"/> Air conditioning <input type="checkbox"/> Commercial <input type="checkbox"/> Test well	
						7 Casing: Material <u>Styrene</u> Height: <u>above</u> below Threaded <input type="checkbox"/> Welded <input type="checkbox"/> Surface <u>30</u> in. Diam. <u>5</u> in. to <u>57</u> ft. depth Drive shoe? <input type="checkbox"/> Yes <input type="checkbox"/> No <u>5</u> in. to <u>57</u> ft. depth	
						8 Screen: Manufacturer <u>Field-Styrene</u> Type <u>3/16</u> Dia. <u>57</u> Slot/gauze <u>3/16</u> Length <u>57</u> Set between <u>55</u> ft. and <u>57</u> ft. Fittings: Gravel pack <input type="checkbox"/> Yes <input checked="" type="checkbox"/> No Size range of material <u> </u>	
						9 Static water level: <u>22</u> ft. below land surface Date <u>12-22-75</u>	
						10 Pumping level below land surfaces: ____ ft. after ____ hrs. pumping ____ g.p.m. ____ ft. after ____ hrs. pumping ____ g.p.m. Estimated maximum yield <u>40 ±</u> g.p.m.	
						11 Water sample submitted: <input type="checkbox"/> Yes <input checked="" type="checkbox"/> No Date <u> </u>	
						12 Well head completion: <input type="checkbox"/> Pitless adapter <u>30</u> inches above grade	
						13 Well grouted? <input checked="" type="checkbox"/> Yes <input type="checkbox"/> No <input checked="" type="checkbox"/> Neat cement <input type="checkbox"/> Bentonite <u> </u> Depth: From <u>0</u> ft. to <u>15</u> ft.	
						14 Nearest source of possible contamination: ft. <u>800</u> Direction <u>East</u> Type <u>Septic Tank</u> Well disinfected upon completion? <input checked="" type="checkbox"/> Yes <input type="checkbox"/> No	
						15 Pump: <input checked="" type="checkbox"/> Not installed Manufacturer's name <u> </u> Model number <u> </u> HP <u> </u> Volts <u> </u> Length of drop pipe <u> </u> ft. capacity <u> </u> g.m.p. Type: <input type="checkbox"/> Submersible <input type="checkbox"/> Turbine <input type="checkbox"/> Jet <input type="checkbox"/> Reciprocating <input type="checkbox"/> Centrifugal <input type="checkbox"/> Other	
						16 Remarks: elevation <u>E1. 841</u> <u>Owner to install slab.</u> <u>MH 2</u> Topography: <input type="checkbox"/> Hill <input type="checkbox"/> Slope <input type="checkbox"/> Upland <input checked="" type="checkbox"/> Valley	
						17 Water well contractor's certification: This well was drilled under my jurisdiction and this report is true to the best of my knowledge and belief. <u>Robison Drilling 316A</u> Business name <u>Perry, Ks.</u> License No. <u> </u> Address <u> </u> Signed <u>Jack W. Robison</u> Date <u>1-19-76</u> Authorized representative	