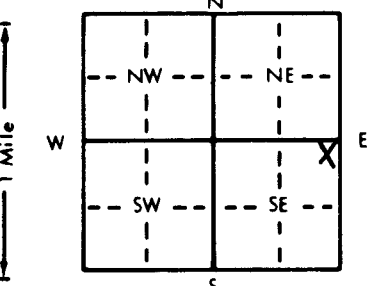


1 LOCATION OF WATER WELL:		Fraction		Section Number		Township Number		Range Number	
County: Jefferson		SE 1/4 NE 1/4 NE 1/4		35		T 11 S		R 19 EW	
Distance and direction from nearest town or city street address of well if located within city? Jefferson -Douglas County Landfill, Perry, Kansas									
2 WATER WELL OWNER:		Hamm, N.R. Asphalt, Inc.							
RR#, St. Address, Box # :		P.O. Box 17							
City, State, ZIP Code :		Perry, Kansas 66073							
3 LOCATE WELL'S LOCATION WITH AN "X" IN SECTION BOX:		4 DEPTH OF COMPLETED WELL: 40.5 ft. ELEVATION:							
		Depth(s) Groundwater Encountered 1. ft. 2. ft. 3. ft. WELL'S STATIC WATER LEVEL ft. below land surface measured on mo/day/yr Pump test data: Well water was ft. after hours pumping gpm Est. Yield gpm: Well water was ft. after hours pumping gpm Bore Hole Diameter 2 in. to 1.5 ft., and 5 in. to 40.5 ft. WELL WATER TO BE USED AS: 5 Public water supply 8 Air conditioning 11 Injection well 1 Domestic 3 Feedlot 6 Oil field water supply 9 Dewatering 12 Other (Specify below) 2 Irrigation 4 Industrial 7 Lawn and garden only 10 Monitoring well Was a chemical/bacteriological sample submitted to Department? Yes No X; If yes, mo/day/yr sample was submitted Water Well Disinfected? Yes No X							
5 TYPE OF BLANK CASING USED:		5 Wrought iron 8 Concrete tile CASING JOINTS: Glued Clamped 1 Steel 3 RMP (SR) 6 Asbestos-Cement 9 Other (specify below) Welded 2 PVC 4 ABS 7 Fiberglass Threaded							
Blank casing diameter 2 in. to 22.0 ft., Dia in. to ft., Dia in. to ft.		Casing height above land surface 30 in., weight Sch. 40 PVC lbs./ft. Wall thickness or gauge No.							
TYPE OF SCREEN OR PERFORATION MATERIAL:		7 PVC 10 Asbestos-cement 1 Steel 3 Stainless steel 5 Fiberglass 8 RMP (SR) 11 Other (specify) 2 Brass 4 Galvanized steel 6 Concrete tile 9 ABS 12 None used (open hole)							
SCREEN OR PERFORATION OPENINGS ARE:		5 Gauzed wrapped 8 Saw cut 11 None (open hole) 1 Continuous slot 3 Mill slot 6 Wire wrapped 9 Drilled holes 2 Louvered shutter 4 Key punched 7 Torch cut 10 Other (specify)							
SCREEN-PERFORATED INTERVALS:		From 22.0 ft. to 40.3 ft., From ft. to ft. From ft. to ft., From ft. to ft.							
GRAVEL PACK INTERVALS:		From 21.0 ft. to 40.5 ft., From ft. to ft. From ft. to ft., From ft. to ft.							
6 GROUT MATERIAL:		1 Neat cement 2 Cement grout 3 Bentonite 4 Other							
Grout Intervals: From 0 ft. to 19.0 ft., From 19.0 ft. to 21.0 ft., From ft. to ft.		10 Livestock pens 14 Abandoned water well What is the nearest source of possible contamination: 11 Fuel storage 15 Oil well/Gas well 1 Septic tank 4 Lateral lines 7 Pit privy 12 Fertilizer storage 16 Other (specify below) 2 Sewer lines 5 Cess pool 8 Sewage lagoon 13 Insecticide storage Landfill some distance away 3 Watertight sewer lines 6 Seepage pit 9 Feedyard							
Direction from well?		How many feet?							
FROM TO LITHOLOGIC LOG FROM TO PLUGGING INTERVALS									
0 2" Topsoil									
2" 1.5 Lean Clay, Brown									
1.5 9.4 Clay, Brown									
9.4 12.5 Weathered Clayey Shale, Olive Brown									
12.5 18.8 Weathered Limestone									
18.8 21.5 Shale, Gray									
21.5 39.5 Limestone, Gray									
39.5 40.5 Shale, Gray and Dark Gray									
7 CONTRACTOR'S OR LANDOWNER'S CERTIFICATION: This water well was (1) constructed, (2) reconstructed, or (3) plugged under my jurisdiction and was completed on (mo/day/year) 9/24/91 and this record is true to the best of my knowledge and belief. Kansas Water Well Contractor's License No. 416 This Water Well Record was completed on (mo/day/yr) 11-1-91 under the business name of Terracon Consultants SE by (signature) E. M. Keat									

INSTRUCTIONS: Use typewriter or ball point pen. PLEASE PRESS FIRMLY and PRINT clearly. Please fill in blanks, underline or circle the correct answers. Send top three copies to Kansas Department of Health and Environment, Bureau of Water, Topeka, Kansas 66620-7320. Telephone: 913-296-5545. Send one to WATER WELL OWNER and retain one for your records.