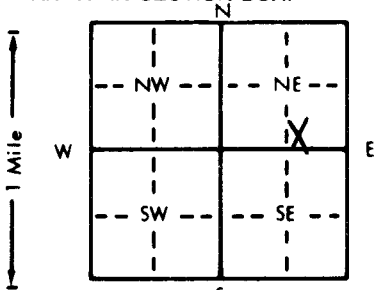


1 LOCATION OF WATER WELL: County: Jefferson		Fraction NE 1/4 SE 1/4 SW 1/4		Section Number 35	Township Number T 11 S	Range Number R 19 E
Distance and direction from nearest town or city street address of well if located within city? Jefferson - Douglas County Landfill, Perry, Kansas						
2 WATER WELL OWNER: RR#, St. Address, Box # : City, State, ZIP Code :		Hamm, N.R. Asphalt, Inc. P.O. Box 17 Perry, Kansas 66073 Board of Agriculture, Division of Water Resources Application Number:				
3 LOCATE WELL'S LOCATION WITH AN "X" IN SECTION BOX: <div style="text-align: center;"></div>		4 DEPTH OF COMPLETED WELL 92.9 ft. ELEVATION: ft. Depth(s) Groundwater Encountered 1. ft. 2. ft. 3. ft. WELL'S STATIC WATER LEVEL ft. below land surface measured on mo/day/yr Pump test data: Well water was ft. after hours pumping gpm Est. Yield gpm: Well water was ft. after hours pumping gpm Bore Hole Diameter 7 in. to 1.5 in. and 5 in. to 92.9 ft. WELL WATER TO BE USED AS: 5 Public water supply 8 Air conditioning 11 Injection well 1 Domestic 3 Feedlot 6 Oil field water supply 9 Dewatering 12 Other (Specify below) 2 Irrigation 4 Industrial 7 Lawn and garden only 10 Monitoring well Was a chemical/bacteriological sample submitted to Department? Yes.....No..... X If yes, mo/day/yr sample was submitted Water Well Disinfected? Yes No X				
5 TYPE OF BLANK CASING USED: 1 Steel 3 RMP (SR) 5 Wrought iron 8 Concrete tile CASING JOINTS: Glued Clamped 2 PVC 4 ABS 6 Asbestos-Cement 9 Other (specify below) Welded Blank casing diameter in. to 52.8 ft. Dia in. to ft. Dia in. to ft. Casing height above land surface 30 in. weight Sch 40 PVC lbs./ft. Wall thickness or gauge No. TYPE OF SCREEN OR PERFORATION MATERIAL: 7 PVC 10 Asbestos-cement 1 Steel 3 Stainless steel 5 Fiberglass 8 RMP (SR) 11 Other (specify) 2 Brass 4 Galvanized steel 6 Concrete tile 9 ABS 12 None used (open hole) SCREEN OR PERFORATION OPENINGS ARE: 5 Gauzed wrapped 8 Saw cut 11 None (open hole) 1 Continuous slot 3 Mill slot 6 Wire wrapped 9 Drilled holes 2 Louvered shutter 4 Key punched 7 Torch cut 10 Other (specify) SCREEN-PERFORATED INTERVALS: From 42.8 ft. to 91.8 ft. From ft. to ft. From ft. to ft. From ft. to ft. GRAVEL PACK INTERVALS: From 49.5 ft. to 92.9 ft. From ft. to ft. From ft. to ft. From ft. to ft.						
6 GROUT MATERIAL: 1 Neat cement 2 Cement grout 3 Bentonite 4 Other Grout Intervals: From 0 ft. to 47.5 ft. From 47.5 ft. to 49.5 ft. From ft. to ft. What is the nearest source of possible contamination: 1 Septic tank 4 Lateral lines 7 Pit privy 11 Livestock pens 14 Abandoned water well 2 Sewer lines 5 Cess pool 8 Sewage lagoon 12 Fuel storage 15 Oil well/Gas well 3 Watertight sewer lines 6 Seepage pit 9 Feedyard 13 Insecticide storage 16 Other (specify below) Landfill some distance away Direction from well? How many feet?						
FROM		TO		LITHOLOGIC LOG		PLUGGING INTERVALS
0		1.2		Clay, Brown		
1.2		1.5		Weathered Limestone		
1.5		14.8		Weathered Limestone		
14.8		15.9		Weathered Shale, Tan Brown		
15.9		21.7		Shale, Gray		
21.7		23.5		Limestone, Gray		
23.5		34.2		Shale, Gray		
34.2		36.2		Weathered Shale, with Limestone Nodules, Tan Brown		
36.2		45.7		Weathered Limestone		
45.7		50.7		Shale, Gray		
50.7		54.5		Shale, with Siltstone Stringers, Gray		
54.5		56.0		Shale, Maroon		
56.0		62.0		Shale, Gray		
62.0		67.0		Shale, Gray and Maroon		
67.0		92.9		Shale, with Siltstone Stringers, Gray		
7 CONTRACTOR'S OR LANDOWNER'S CERTIFICATION: This water well was 1 constructed, (2) reconstructed, or (3) plugged under my jurisdiction and was completed on (mo/day/year) 9/23/91 and this record is true to the best of my knowledge and belief. Kansas Water Well Contractor's License No. 416 This Water Well Record was completed on (mo/day/year) 9/23/91 under the business name of Terracon Consultants, SE by (signature) <i>[Signature]</i>						
INSTRUCTIONS: Use typewriter or ball point pen. PLEASE PRESS FIRMLY and PRINT clearly. Please fill in blanks, underline or circle the correct answers. Send top three copies to Kansas Department of Health and Environment, Bureau of Water, Topeka, Kansas 66620-7320. Telephone: 913-296-5545. Send one to WATER WELL OWNER and retain one for your records.						