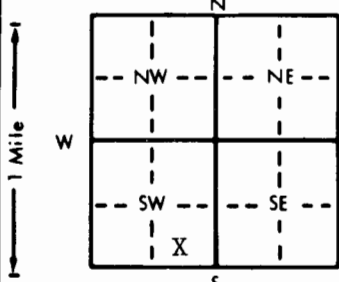


1 LOCATION OF WATER WELL:		Fraction	Section Number		Township Number	Range Number
County: JEFFERSON		LOT 1 $\frac{1}{4}$ E $1\frac{1}{2}$ $\frac{1}{4}$ SW $\frac{1}{4}$	30		T 11 S	R 19 EW
Distance and direction from nearest town or city street address of well if located within city?						
TWO MILES EAST OF PERRY, KS. ON U.S. HWY 24 & $3\frac{1}{4}$ MILES SOUTH & 700' WEST						
2 WATER WELL OWNER: ALAN M HILL						
RR#, St. Address, Box # : 2801 LAKEVIEW RD				Board of Agriculture, Division of Water Resources		
City, State, ZIP Code : LAWRENCE KS 66044				Application Number: 43361		
3 LOCATE WELL'S LOCATION WITH AN "X" IN SECTION BOX:		4 DEPTH OF COMPLETED WELL: 71 ft. ELEVATION:				
		Depth(s) Groundwater Encountered 1. 18 ft. 2. ft. 3. ft.				
		WELL'S STATIC WATER LEVEL 18 ft. below land surface measured on mo/day/yr 7-12-98				
		Pump test data: Well water was 21 ft. after 1 hours pumping 500 gpm				
		Est. Yield 1000 gpm: Well water was 23 ft. after 2 hours pumping 500 gpm				
		Bore Hole Diameter 32 in. to 71 ft. and in. to ft.				
		WELL WATER TO BE USED AS:				
		1 Domestic 3 Feedlot 6 Oil field water supply 9 Dewatering 12 Other (Specify below)				
		2 Irrigation 4 Industrial 7 Lawn and garden only 10 Monitoring well				
		Was a chemical/bacteriological sample submitted to Department? Yes No XX; If yes, mo/day/yr sample was submitted				
		Water Well Disinfected? Yes No XX				
5 TYPE OF BLANK CASING USED:						
1 Steel 3 RMP (SR) 5 Wrought iron 8 Concrete tile CASING JOINTS: Glued X Clamped X						
2 PVC 4 ABS 6 Asbestos-Cement 9 Other (specify below) Welded						
7 Fiberglass Threaded						
Blank casing diameter 16 in. to 51 ft., Dia in. to ft.						
Casing height above land surface 12 in., weight lbs./ft. Wall thickness or gauge No. 50						
TYPE OF SCREEN OR PERFORATION MATERIAL:						
1 Steel 3 Stainless steel 5 Fiberglass 8 RMP (SR) 10 Asbestos-cement						
2 Brass 4 Galvanized steel 6 Concrete tile 9 ABS 11 Other (specify)						
12 None used (open hole)						
SCREEN OR PERFORATION OPENINGS ARE:						
1 Continuous slot 3 Mill slot 5 Gauzed wrapped 8 Saw cut 11 None (open hole)						
2 Louvered shutter 4 Key punched 6 Wire wrapped 9 Drilled holes						
7 Torch cut 10 Other (specify)						
SCREEN-PERFORATED INTERVALS: From 51 ft. to 71 ft., From ft. to ft.						
From ft. to ft., From ft. to ft.						
GRAVEL PACK INTERVALS: From 20 ft. to 71 ft., From ft. to ft.						
From ft. to ft., From ft. to ft.						
6 GROUT MATERIAL: 1 Neat cement 2 Cement grout 3 Bentonite 4 Other						
Grout Intervals: From 0 ft. to 20 ft., From ft. to ft., From ft. to ft.						
What is the nearest source of possible contamination:						
1 Septic tank 4 Lateral lines 7 Pit privy 10 Livestock pens 14 Abandoned water well						
2 Sewer lines 5 Cess pool 8 Sewage lagoon 11 Fuel storage 15 Oil well/Gas well						
3 Watertight sewer lines 6 Seepage pit 9 Feedyard 12 Fertilizer storage 16 Other (specify below)						
13 Insecticide storage NONE						
Direction from well? How many feet?						
FROM	TO	LITHOLOGIC LOG	FROM	TO	PLUGGING INTERVALS	
0	2	BLACK TOP SOIL				
2	17	BROWN SILT				
17	18	FINE BROWN SAND & GREY CLAY				
18	26	HARD GREY CLAY				
26	38	SMALL-MEDIUM BROWN GRAVEL				
38	41	FINE GREY SAND & GREY CLAY				
41	51	SMALL-MEDIUM GREY GRAVEL				
51	71	MEDIUM-LARGE BROWN GRAVEL				
	71	BOULDERS , STOPPED				
7 CONTRACTOR'S OR LANDOWNER'S CERTIFICATION: This water well was (1) constructed, (2) reconstructed, or (3) plugged under my jurisdiction and was completed on (mo/day/year) 7-13-98 and this record is true to the best of my knowledge and belief. Kansas Water Well Contractor's License No. 323 This Water Well Record was completed on (mo/day/yr) 7-15-98 under the business name of HOOBLER DRILLING by (signature)						