

1 LOCATION OF WATER WELL:	Fraction	Section Number	Township Number	Range Number
County: JEFFERSON	SE ¼ SE ¼ SW ¼	20	T 11 S	R 19 E/W

Distance and direction from nearest town or city street address of well if located within city?


1 north of Williamstown

2 WATER WELL OWNER: Jim King
RR#, St. Address, Box # : Rt. 1 Box 293
City, State, ZIP Code : Perry, KS 66073

Board of Agriculture, Division of Water Resources

Application Number:

3 LOCATE WELL'S LOCATION WITH AN "X" IN SECTION BOX: 4 DEPTH OF COMPLETED WELL... 80'..... ft. ELEVATION: 371'..... ft. 0'

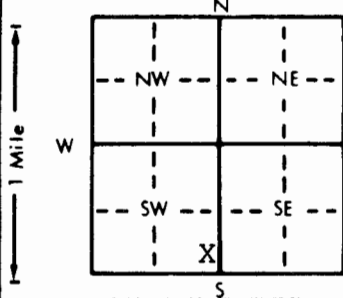

Depth(s) Groundwater Encountered 1. 37' ft. 2. ft. 3. ft.

WELL'S STATIC WATER LEVEL .. 14' ft. below land surface measured on mo/day/yr 8-18-94

Pump test data: Well water was ft. after hours pumping gpm

Est. Yield 2 gpm: Well water was ft. after hours pumping gpm

Bore Hole Diameter . . **12"** . . . in. to . . . ft., and . . . in. to . . . ft.

WELL WATER TO BE USED AS: 5 Public water supply 8 Air conditioning 11 Injection well

1 Domestic	3 Feedlot	6 Oil field water supply	9 Dewatering	12 Other (Specify below)
------------	-----------	--------------------------	--------------	--------------------------

2 Irrigation 4 Industrial 7 Lawn and garden only 10 Monitoring well

Was a chemical/bacteriological sample submitted to Department? Yes.....No X.....; If yes, mo/day/yr sample was submitted
Water Well Disinfected? Yes X No

Water Well Disinfected? Yes ☒ No ☐

5	TYPE OF BLANK CASING USED:		5 Wrought iron	8 Concrete tile	CASING JOINTS: Glued Clamped Welded Threaded
	1 Steel	3 RMP (SR)	6 Asbestos-Cement	9 Other (specify below)	
	2 PVC	4 ABS	7 Fiberglass		

Blank casing diameter 5" . . . in. to 0-30 . . . ft. Dia . . . 5" . . . in. to 42-79 . . . ft. Dia . . . in. to . . . ft.
Casing height above land surface 24" . . . in. weight . . . 2.82 . . . lbs./ft. Wall thickness or gauge No. .258.

TYPE OF SCREEN OR PERFORATION MATERIAL:			7 PVC	10 Asbestos-cement
1 Steel	3 Stainless steel	5 Fiberglass	8 RMP (SR)	11 Other (specify)
2 Brass	4 Galvanized steel	6 Concrete tile	9 ABS	12 None used (open hole)

SCREEN OR PERFORATION OPENINGS ARE:		5 Gauzed wrapped	<u>8 Saw cut</u>	11 None (open hole)
1 Continuous slot	3 Mill slot	6 Wire wrapped	9 Drilled holes	
2 Louvered shutter	4 Key punched	7 Torch cut	10 Other (specify)	

SCREEN-PERFORATED INTERVALS:	From 30 ft. to 42 ft.,	From ft. to ft.
	From 79 ft. to 80 ft.,	From ft. to ft.
GRAVEL PACK INTERVALS:	From ft. to ft.,	From ft. to ft.
	From ft. to ft.,	From ft. to ft.

6 GROUT MATERIAL: 1 Neat cement 2 Cement grout 3 Bentonite 4 Other

Grout Intervals: From 4 ft. to 24 ft. From ft. to ft. From ft. to ft.

What is the nearest source of possible contamination:

1 Septic tank	4 Lateral lines	7 Pit privy	10 Livestock pens	14 Abandoned water well
2 Sewer lines	5 Cess pool	8 Sewage lagoon	11 Fuel storage	15 Oil well/Gas well
3 Watertight sewer lines	6 Seepage pit	9 Feedyard	12 Fertilizer storage	16 Other (specify below)
			13 Insecticide storage	

Direction from well? south How many feet? 200'

[illegible]

7 CONTRACTOR'S OR LANDOWNER'S CERTIFICATION: This water well was (1) constructed, (2) reconstructed, or (3) plugged under my jurisdiction and was completed on (mo/day/year) 8-18-94 and this record is true to the best of my knowledge and belief. Kansas Water Well Contractor's License No. 182 This Water Well Record was completed on (mo/day/yr) 9-16-94 under the business name of STRADER DRILLING CO., INC. by (signature) Dale Skren