


1 LOCATION OF WATER WELL: Fraction NW 1/4 SW 1/4 NW 1/4 Section Number 35 Township Number T 11 S Range Number R 2 E/W*
 County: Dickinson

Distance and direction from nearest town or city street address of well if located within city?
1/2 mile North of Talmage, Ks to Hwy 18 & 4 East on Hwy 18 to Indy Rd & 1.66 mile

2 WATER WELL OWNER: Preston Longnecker North
 RR#, St. Address, Box # : 3260 Indy Rd Board of Agriculture, Division of Water Resources
 City, State, ZIP Code : Abilene, Kansas 67410 Application Number:

3 LOCATE WELL'S LOCATION WITH AN "X" IN SECTION BOX: 4 DEPTH OF COMPLETED WELL10.8..... ft. ELEVATION:

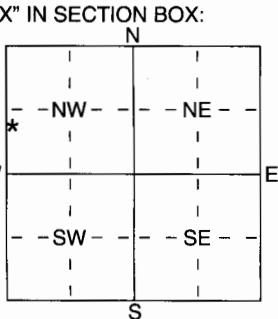

Depth(s) Groundwater Encountered 19.9..... ft. 2 ft. 3 ft.
 WELL'S STATIC WATER LEVEL8.8..... ft. below land surface measured on mo/day/yr 2 / 2 / 0.6
 Pump test data: Well water was ft. after hours pumping gpm
 Est. Yield1.0..... gpm: Well water was ft. after hours pumping gpm
 WELL WATER TO BE USED AS: 5 Public water supply 8 Air conditioning 11 Injection well
 1 Domestic 3 Feedlot 6 Oil field water supply 9 Dewatering 12 Other (Specify below)
 2 Irrigation 4 Industrial 7 Domestic (lawn & garden) 10 Monitoring well

Was a chemical/bacteriological sample submitted to Department? Yes No* ; If yes, mo/day/yr sample was submitted
 Water Well Disinfected? Yes * No

5 TYPE OF BLANK CASING USED: 5 Wrought iron 8 Concrete tile CASING JOINTS: Glued * Clamped
 1 Steel 3 RMP (SR) 6 Asbestos-Cement 9 Other (specify below) Welded
 2 PVC 4 ABS 7 Fiberglass Threaded

Blank casing diameter5..... in. to10.8..... ft., Dia in. to ft., Dia in. to ft.
 Casing height above land surface1.7..... in., weight2.00..... lbs./ft. Wall thickness or gauge No. 2.50

TYPE OF SCREEN OR PERFORATION MATERIAL: 7 PVC 10 Asbestos-Cement
 1 Steel 3 Stainless Steel 5 Fiberglass 8 RMP (SR) 11 Other (Specify)
 2 Brass 4 Galvanized Steel 6 Concrete tile 9 ABS 12 None used (open hole)

SCREEN OR PERFORATION OPENINGS ARE: 5 Gauzed wrapped 8 Saw cut 11 None (open hole)
 1 Continuous slot 3 Mill slot 6 Wire wrapped 9 Drilled holes
 2 Louvered shutter 4 Key punched 7 Torch cut 10 Other (specify) ft.

SCREEN-PERFORATED INTERVALS: From8.8..... ft. to10.8..... ft., From ft. to ft.
 GRAVEL PACK INTERVALS: From2.6..... ft. to10.8..... ft., From ft. to ft.

6 GROUT MATERIAL: 1 Neat cement 2 Cement grout 3 Bentonite 4 Other
 Grout Intervals: From4..... ft. to2.6..... ft., From ft. to ft., From ft. to ft.

What is the nearest source of possible contamination:
 1 Septic tank 4 Lateral lines 7 Pit privy 10 Livestock pens 14 Abandoned water well
 2 Sewer lines 5 Cess pool 8 Sewage lagoon 11 Fuel storage 15 Oil well/Gas well
 3 Watertight sewer lines 6 Seepage pit 9 Feedyard 12 Fertilizer storage 16 Other (specify below)
 13 Insecticide storage

Direction from well? NORTH APPROX How many feet? 150+

FROM	TO	LITHOLOGIC LOG	FROM	TO	PLUGGING INTERVALS
0	2	DARK TOP SOIL	99	103	SOFT TAN CLAY
2	7	TAN CLAY	103	105	HARD LIMESTONE
7	13	LITE BROWN CLAY	105	108	RED & GRAY SHALE
13	21	LITE COLOR CLAY			
21	22	LITE COLOR LIMESTONE			
22	48	LITE COLOR SHALE			
48	63	LITE GRAY CLAY & SHALE			
63	68	VERY HARD LITE COLOR LIMESTONE			
68	69	LITE COLOR SHALE			
69	70	LITE COLOR LIMESTONE & SHALE			
70	79	GRAY SHALE & CLAY			
79	80	HARD LIMESTONE			
80	85	LITE COLOR LIMESTONE			
85	99	RED & GRAY SHALE MIXED			

7 CONTRACTOR'S OR LANDOWNER'S CERTIFICATION: This water well was (1) constructed, (2) reconstructed, or (3) plugged under my jurisdiction and was completed on (mo/day/year) 2 / 2 / 0.6 and this record is true to the best of my knowledge and belief. Kansas Water Well Contractor's Licence No39.7..... This Water Well Record was completed on (mo/day/yr) 2 / 10 / 0.6 under the business name of CENTRAL KANSAS DRILLING by (signature) David D. Martin