


1 LOCATION OF WATER WELL: Fraction Section Number Township Number Range Number
 County: Dickinson NW ¼ NW ¼ NE ¼ 8 T 13 S R 2 EAA*

Distance and direction from nearest town or city street address of well if located within city?

From Abilene, Ks on Hwy 15 & old Hwy 40 go North on Hwy 15 to 2400 Ave & West to

2 WATER WELL OWNER: Larry Houston 2401 Game Rd
 RR#, St. Address, Box # : 2401 Game Rd Board of Agriculture, Division of Water Resources
 City, State, ZIP Code : Abilene, Kansas 67410 Application Number:

3 LOCATE WELL'S LOCATION WITH AN "X" IN SECTION BOX: 4 DEPTH OF COMPLETED WELL 4.7 ft. ELEVATION:

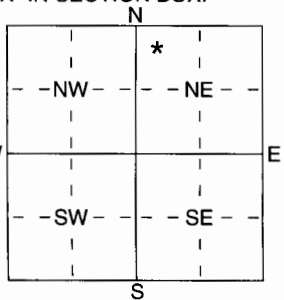

Depth(s) Groundwater Encountered 1 4.3 ft. 2 ft. 3 ft.
 WELL'S STATIC WATER LEVEL 1.7 ft. below land surface measured on mo/day/yr 2 2.2 / 0.6
 Pump test data: Well water was ft. after hours pumping gpm
 Est. Yield 8 gpm: Well water was ft. after hours pumping gpm
 WELL WATER TO BE USED AS: 5 Public water supply 8 Air conditioning 11 Injection well
 1 Domestic 3 Feedlot 6 Oil field water supply 9 Dewatering 12 Other (Specify below)
 2 Irrigation 4 Industrial 7 Domestic (lawn & garden) 10 Monitoring well

Was a chemical/bacteriological sample submitted to Department? Yes No *; If yes, mo/day/yr sample was submitted
 Water Well Disinfected? Yes * No

5 TYPE OF BLANK CASING USED: 5 Wrought iron 8 Concrete tile CASING JOINTS: Glued * Clamped
 1 Steel 3 RMP (SR) 6 Asbestos-Cement 9 Other (specify below) Welded
 2 PVC 4 ABS 7 Fiberglass Threaded

Blank casing diameter 5 in. to 4.7 ft., Dia in. to ft., Dia in. to ft.
 Casing height above land surface 2.4 in., weight 200 lbs./ft. Wall thickness or gauge No. 25.0

TYPE OF SCREEN OR PERFORATION MATERIAL: 7 PVC 10 Asbestos-Cement
 1 Steel 3 Stainless Steel 5 Fiberglass 8 RMP (SR) 11 Other (Specify)
 2 Brass 4 Galvanized Steel 6 Concrete tile 9 ABS 12 None used (open hole)

SCREEN OR PERFORATION OPENINGS ARE: 5 Guazed wrapped 8 Saw cut 11 None (open hole)
 1 Continuous slot 3 Mill slot 6 Wire wrapped 9 Drilled holes
 2 Louvered shutter 4 Key punched 7 Torch cut 10 Other (specify)

SCREEN-PERFORATED INTERVALS: From 4.3 ft. to 4.7 ft., From ft. to ft.
 GRAVEL PACK INTERVALS: From 2.0 ft. to 4.7 ft., From ft. to ft.

6 GROUT MATERIAL: 1 Neat cement 2 Cement grout 3 Bentonite 4 Other
 Grout Intervals: From 0 ft. to 2.0 ft., From ft. to ft.

What is the nearest source of possible contamination:
 1 Septic tank 4 Lateral lines 7 Pit privy 10 Livestock pens 14 Abandoned water well
 2 Sewer lines 5 Cess pool 8 Sewage lagoon 11 Fuel storage 15 Oil well/Gas well
 3 Watertight sewer lines 6 Seepage pit 9 Feedyard 12 Fertilizer storage 16 Other (specify below)
 13 Insecticide storage

Direction from well? WEST APPROX How many feet? 120

FROM	TO	LITHOLOGIC LOG	FROM	TO	PLUGGING INTERVALS
0	9	DARK CLAY			
9	15	LITE COLOR CLAY			
15	20	LITE GRAY CLAY			
20	30	DARK GRAY CLAY			
30	40	SOFT BLACK MUD			
40	43	FINE SAND			
43	44	DARK SHALE			
44	45	GRAY CLAY			
45	47	GRAY SHALE			

7 CONTRACTOR'S OR LANDOWNER'S CERTIFICATION: This water well was (1) constructed, (2) reconstructed, or (3) plugged under my jurisdiction and was completed on (mo/day/year) 2 / 22 / 06 and this record is true to the best of my knowledge and belief. Kansas Water Well Contractor's Licence No 397 This Water Well Record was completed on (mo/day/yr) 3 / 12 / 06 under the business name of CENTRAL KANSAS DRILLING by (signature) Harold R. Martin