not found
wrong location

USE TYPEWRITER OR BALL POINT PEN-PRESS FIRMLY, PRINT CLEARLY.

WATER WELL RECORD
KSA 82a-1201-1215

Wakemer
945-3208

Kansas Department of Health and Environment-Division of Environment
(Water well Contractors)
Topeka, Kansas 66620

1. Location of well:	County	Fraction	Section number	Township number	Range number
	Leavenworth	NW 1/4 NW 1/4 SW 1/4	12	T 11S S	R 20 E/W

2. Distance and direction from nearest town or city: 2 miles west of Tonganoxie, Kansas
Street address of well location if in city:

3. Owner of well: Harold Meeder
R.R. or street: 5828 N. Colrain
City, state, zip code: Kansas City, Missouri

4. Locate with "X" in section below:

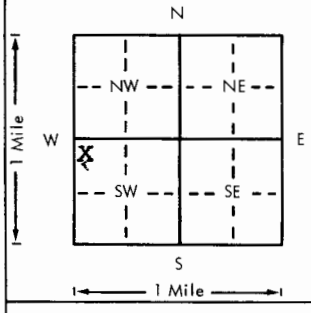

Sketch map:

6. Bore hole dia. 8 in. Completion date 11-1-79
Well depth 40 ft.

7. X Cable tool __ Rotary __ Driven __ Dug
__ Hollow rod __ Jetted __ Bored __ Reverse rotary

8. Use: X Domestic __ Public supply __ Industry
__ Irrigation __ Air conditioning __ Stock
__ Lawn __ Oil field water __ Other

9. Casing: Material PL.
Threaded ___ Welded X
RMP ___ PVC XX
Dia. 5 in. to 41 ft. depth
Dia. ___ in. to ___ ft. depth
Height: Above or below Surface — 18 in.
Weight ___ lbs./ft.
Wall Thickness: inches or gage No. .265

10. Screen: Manufacturer's name (Slotted Pipe) Vinyplex, Inc.
Type PVC Dia. 5"
Slot/gauze .06 1/16 Length 20'
Set between 20 ft. and 40 ft.
___ ft. and ___ ft.
Gravel pack? XX Size range of material 1/4-1/8

11. Static water level: 14 ft. below land surface Date 11-1-79 mo./day/yr.

12. Pumping level below land surfaces:
___ ft. after ___ hrs. pumping ___ g.p.m.
___ ft. after ___ hrs. pumping ___ g.p.m.
Estimated maximum yield 20 g.p.m.

13. Water sample submitted: mo./day/yr.
__ Yes X No Date

14. Well head completion:
X Pitless adapter 18 inches above grade

15. Well grouted? Yes
With: X Neat cement ___ Bentonite ___ Concrete
Depth: From 3 ft. to 15 ft.

16. Nearest source of possible contamination:
ft. 200 Direction west Type septic
Well disinfected upon completion? X Yes ___ No

17. Pump: X Not installed
Manufacturer's name
Model number ___ HP ___ Volts ___
Length of drop pipe ___ ft. capacity ___ g.p.m.
Type:
__ Submersible __ Turbine
__ Jet __ Reciprocating
__ Centrifugal __ Other

5. Type and color of material	From	To
Top Soil	0	7
Clay	7	11
Silty Sand	11	18
Blue Mud	18	40

(Use a second sheet if needed)

18. Elevation:
Topography:
__ Hill
__ Slope
__ Upland
__ Valley

19. Remarks:

20. Water well contractor's certification:
This well was drilled under my jurisdiction and this report is true to the best of my knowledge and belief.
Business name BREUER, INC. License No. 174
Address Box 147, Basehor, Ks.
Signed (Authorized representative) Date 11-5-79

T 11 R 20 E/W Sec 12 1/4 NWNSW

Forward the white, blue and pink copies to the Department of Health and Environment

Form WWC-5

MI-1023