


1 LOCATION OF WATER WELL: County: LEAVENWORTH Fraction: NE 1/4 NE 1/4 SW 1/4 Section Number: 13 Township Number: T 11 S Range Number: R 20 EW

Distance and direction from nearest town or city street address of well if located within city?
2 miles WST - 1 South West 1/2 South of TONGANOXIE

2 WATER WELL OWNER: KERRY PUTTHOFF
 RR#, St. Address, Box #: 17559 242nd Board of Agriculture, Division of Water Resources
 City, State, ZIP Code: TONGANOXIE, KS 66086 Application Number:

3 LOCATE WELL'S LOCATION WITH AN "X" IN SECTION BOX:

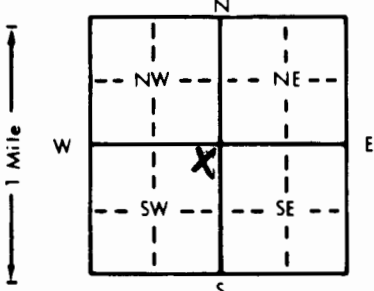

4 DEPTH OF COMPLETED WELL: 84 ft. ELEVATION: 37 ft.

Depth(s) Groundwater Encountered 1. 14 ft. 2. 25 ft. 3. 37 ft.
 WELL'S STATIC WATER LEVEL 14 ft. below land surface measured on mo/day/yr 10-5-92

Pump test data: Well water was _____ ft. after _____ hours pumping _____ gpm
 Est. Yield 2.5 gpm; Well water was _____ ft. after _____ hours pumping _____ gpm

Bore Hole Diameter: 8 in. to 84 ft., and _____ in. to _____ ft.

WELL WATER TO BE USED AS:
 Domestic 3 Feedlot 6 Oil field water supply 9 Dewatering 12 Other (Specify below)
 Irrigation 4 Industrial 7 Lawn and garden only 10 Monitoring well

Was a chemical/bacteriological sample submitted to Department? Yes _____ No
 If yes, mo/day/yr sample was submitted _____
 Water Well Disinfected? Yes No

5 TYPE OF BLANK CASING USED:
 Steel 3 RMP (SR) 5 Wrought iron 8 Concrete tile CASING JOINTS: Glued Clamped _____
 PVC 4 ABS 7 Fiberglass _____ Welded _____
 Blank casing diameter 5 in. to 24 ft., Dia 5 in. to 79 ft., Dia _____ in. to _____ ft.
 Casing height above land surface 24 in., weight _____ lbs./ft. Wall thickness or gauge No. S02-26

TYPE OF SCREEN OR PERFORATION MATERIAL:
 Steel 3 Stainless steel 5 Fiberglass 8 RMP (SR) 10 Asbestos-cement
 Brass 4 Galvanized steel 6 Concrete tile 9 ABS 11 Other (specify) _____
 Mill slot 12 None used (open hole)

SCREEN OR PERFORATION OPENINGS ARE:
 Continuous slot Mill slot 5 Gauzed wrapped 8 Saw cut 11 None (open hole)
 Louvered shutter 4 Key punched 6 Wire wrapped 9 Drilled holes
 Torch cut 10 Other (specify) _____

SCREEN-PERFORATED INTERVALS: From 24 ft. to 39 ft., From 79 ft. to 84 ft.
 From _____ ft. to _____ ft., From _____ ft. to _____ ft.

GRAVEL PACK INTERVALS: From 20 ft. to 84 ft., From _____ ft. to _____ ft.
 From _____ ft. to _____ ft., From _____ ft. to _____ ft.

6 GROUT MATERIAL: 1 Neat cement 2 Cement grout Bentonite 4 Other _____
 Grout Intervals: From 0 ft. to 24 ft., From _____ ft. to _____ ft.

What is the nearest source of possible contamination:
 Septic tank 4 Lateral lines 7 Pit privy 11 Fuel storage 14 Abandoned water well
 Sewer lines 5 Cess pool 8 Sewage lagoon 12 Fertilizer storage 15 Oil well/Gas well
 Watertight sewer lines 6 Seepage pit 9 Feedyard 13 Insecticide storage Other (specify below)

Direction from well? NONE AT TIME OF DRILLING How many feet? NEW HOUSE

FROM	TO	LITHOLOGIC LOG	FROM	TO	PLUGGING INTERVALS
0	6	SOIL - CLAY			
6	16	SANDY CLAY			
16	30	Br. Sandstone / Clay breaks			
30	37	Gray shale			
37	48	Br. Sandstone / Gray shale breaks			
48	58	Sandy Gray shale			

7 CONTRACTOR'S OR LANDOWNER'S CERTIFICATION: This water well was constructed, (2) reconstructed, or (3) plugged under my jurisdiction and was completed on (mo/day/year) 10-7-92 and this record is true to the best of my knowledge and belief. Kansas Water Well Contractor's License No. 536 This Water Well Record was completed on (mo/day/yr) 10-27-92 under the business name of PATCHEN PUMP & WELL DRILLING INC. by (signature) Tom Patchen