


1) LOCATION OF WATER WELL:	Fraction	Section Number	Township Number	Range Number
County: <u>Leavenworth</u>	<u>SE 1/4 NE 1/4 NW 1/4</u>	<u>25</u>	T <u>11</u> S	R <u>20</u> <u>EW</u>

1 w 1 N of Reno

Board of Agriculture, Division of Water Resources
Application Number:

Depth(s) Groundwater Encountered 1. 35 ft. 2. _____ ft. 3. _____ ft.

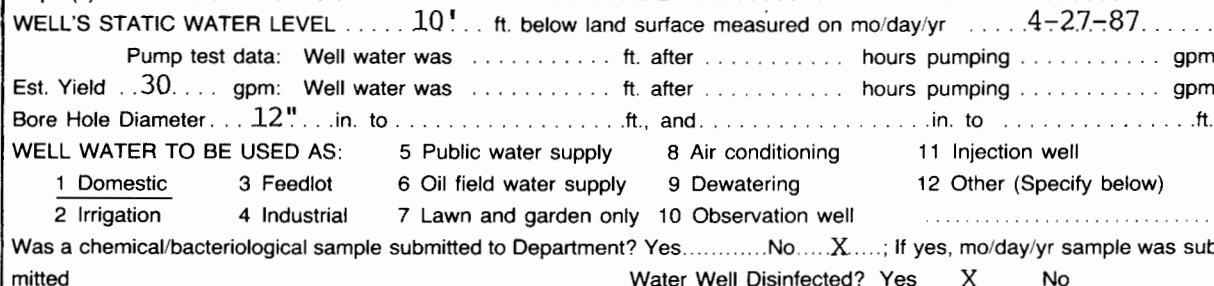

1 Steel	3 RMP (SR)	6 Asbestos-Cement	9 Other (specify below)	Welded
2 PVC	4 ABS	7 Fiberglass		Threaded

Blank casing diameter 5" . . . in. to . . . 0-41 . . . ft. Dia . . . in. to . . . ft. Dia . . . in. to . . . ft.
Casing height above land surface 24 . . . in. weight . . . 2.82 . . . lbs./ft. Wall thickness or gauge No. . . 258

1 Steel	3 Stainless steel	5 Fiberglass	8 RMP (SR)	11 Other (specify)
2 Brass	4 Galvanized steel	6 Concrete tile	9 ABS	12 None used (open hole)

1 Continuous slot	3 Mill slot	6 Wire wrapped	9 Drilled holes
2 Louvered shutter	4 Key punched	7 Torch cut	10 Other (specify)

SCREEN-PERFORATED INTERVALS: From . . . 41 ft. to . . . 46 ft., From ft. to ft.
 From ft. to ft., From ft. to ft.
 GRAVEL PACK INTERVALS: From . . . 15 ft. to . . . 46 ft., From ft. to ft.
 From ft. to ft., From ft. to ft.

6 GROUT MATERIAL: 1 Neat cement 2 Cement grout 3 Bentonite 4 Other

Grout Intervals: From 0 ft. to 20 ft. From ft. to ft. From ft. to ft.

What is the nearest source of possible contamination:

1 <u>Septic tank</u>	4 Lateral lines	7 Pit privy	11 Fuel storage	15 Oil well/Gas well
2 Sewer lines	5 Cess pool	8 Sewage lagoon	12 Fertilizer storage	16 Other (specify below)
3 Watertight sewer lines	6 Seepage pit	9 Feedyard	13 Insecticide storage	

Direction from well? ~~130~~ 140 How many feet? 130

[illegible]

7. CONTRACTOR'S OR LANDOWNER'S CERTIFICATION: This water well was (1) constructed, (2) reconstructed, or (3) plugged under my jurisdiction and was completed on (mo/day/year) 4-27-87 and this record is true to the best of my knowledge and belief. Kansas

Water Well Contractor's License No. 182 This Water Well Record was completed on (mo/day/yr) 6-1-87
under the business name of Strader Drilling Co., Inc. by (signature) [Signature]

INSTRUCTIONS: Use typewriter or ball point pen. PLEASE PRESS FIRMLY and PRINT clearly. Please fill in blanks, underline or circle the correct answers. Send top three copies to Kansas Department of Health and Environment, Office of Oil Field and Environmental Geology, Regulation and Permitting Section, Topeka, Kansas 66620-7500, Telephone: 913-862-9360. Send one to WATER WELL OWNER and retain one for your records.