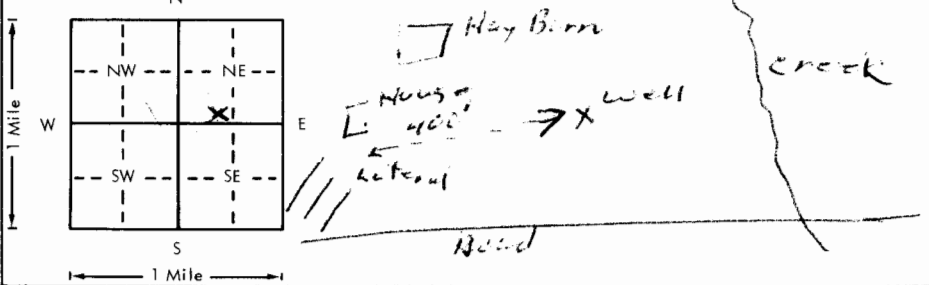


USE TYPEWRITER OR BALL POINT PEN-PRESS FIRMLY, PRINT CLEARLY.

WATER WELL RECORD
KSA 82a-1201-1215

Kansas Department of Health and Environment-Division of Environment
(Water well Contractors)
Topeka, Kansas 66620

1. Location of well: County LEAVENWORTH Fraction SE 1/4 SW 1/4 NE 1/4 Section number 24 Township number T 11 S R 20 E/W Range number	
2. Distance and direction from nearest town or city: 2 W 2 1/2 S Street address of well location if in city: Tonganoxie	
3. Owner of well: Bill Moore R.R. or street: RR City, state, zip code: Tonganoxie	
4. Locate with "X" in section below: Sketch map: 	
5. Type and color of material	
	From To
Top Soil	0 9
Silty Soil	9 14
Creek Gravel 3/4	14 85
Gray Shale	15 34
Gray Shaley Sand Stone	34 87
Brown Line Stone	84 87
Gray Shale	87 140
(Use a second sheet if needed)	
18. Elevation: Topography: <input type="checkbox"/> Hill <input type="checkbox"/> Slope <input type="checkbox"/> Upland <input checked="" type="checkbox"/> Valley	19. Remarks: owner will pour slab
20. Water well contractor's certification: This well was drilled under my jurisdiction and this report is true to the best of my knowledge and belief. Business name: Strayer Drky Co Inc License No. 182 Address: 671 Helton, KS Signed: Wade Cochran Date: 1-15 Authorized representative	

6. Bore hole dia. 10 in. Completion date _____ Well depth 140 ft. 1-12-77
7. Cable tool <input checked="" type="checkbox"/> Rotary <input type="checkbox"/> Driven <input type="checkbox"/> Dug <input type="checkbox"/> Hollow rod <input type="checkbox"/> Jetted <input type="checkbox"/> Bored <input type="checkbox"/> Reverse rotary
8. Use: <input type="checkbox"/> Domestic <input type="checkbox"/> Public supply <input type="checkbox"/> Industry <input type="checkbox"/> Irrigation <input type="checkbox"/> Air conditioning <input type="checkbox"/> Stock <input type="checkbox"/> Lawn <input type="checkbox"/> Oil field water <input type="checkbox"/> Other
9. Casing: Material PVC Height: <u>Above</u> or below Threaded <input type="checkbox"/> Welded <input type="checkbox"/> Surface 24 in. RMP <input type="checkbox"/> PVC 3/4 Weight 2.75 lbs./ft. Dia. 5 in. to 140 ft. depth Wall Thickness: inches or Dia. <input type="checkbox"/> in. to <input type="checkbox"/> ft. depth Gage No. 225
10. Screen: Manufacturer's name Pumco Type PVC Dia. 5 Slot/gauze .090 Length 15 Set between 15 ft. and 20 ft. 115 ft. and 120 ft. Gravel pack? <input checked="" type="checkbox"/> Size range of material 20-24
11. Static water level: _____ mo./day/yr. 15 ft. below land surface Date 1-12-77
12. Pumping level below land surfaces: AIR TEST _____ ft. after _____ hrs. pumping _____ g.p.m. _____ ft. after _____ hrs. pumping _____ g.p.m. Estimated maximum yield 154 _____ g.p.m.
13. Water sample submitted: _____ mo./day/yr. <input type="checkbox"/> Yes <input checked="" type="checkbox"/> No Date _____
14. Well head completion: capped <input type="checkbox"/> Pitless adapter 24 Inches above grade
15. Well grouted? <input checked="" type="checkbox"/> With: <input checked="" type="checkbox"/> Neat cement <input type="checkbox"/> Bentonite <input type="checkbox"/> Concrete Depth: From 0 ft. to 10 ft.
16. Nearest source of possible contamination: ft. 400 Direction SW Type Lateral Well disinfected upon completion? <input type="checkbox"/> Yes <input checked="" type="checkbox"/> No
17. Pump: <input checked="" type="checkbox"/> Not installed Manufacturer's name _____ Model number _____ HP _____ Volts _____ Length of drop pipe _____ ft. capacity _____ g.p.m. Type: <input type="checkbox"/> Submersible <input type="checkbox"/> Turbine <input type="checkbox"/> Jet <input type="checkbox"/> Reciprocating <input type="checkbox"/> Centrifugal <input type="checkbox"/> Other

L-1-15-77
R
SE 1/4 SW 1/4 NE 1/4