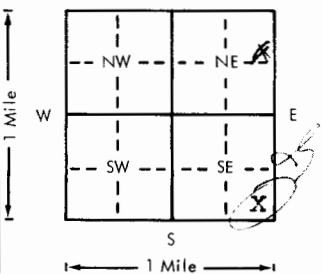


USE TYPEWRITER OR BALL
POINT PEN-PRESS FIRMLY,
PRINT CLEARLY.

WATER WELL RECORD
KSA 82a-1201-1215

Kansas Department of Health and
Environment-Division of Environment
(Water well Contractors)
Topeka, Kansas 66620

1. Location of well:		County Leavenworth	Fraction NE NE SE / SE SE / SE SE / SE	Section number 26	Township number 11	Range number 20	EW
2. Distance and direction from nearest town or city: 1 1/2 miles west of Reno, Ks. & 1 1/2 miles north			3. Owner of well: Mr. Rich Bailey R.R. or street: Route 1, Box 105B City, state, zip code: Tonganoxie, Kansas 66086				
4. Locate with "X" in section below:			Sketch map:				
							
5. Type and color of material			From	To	6. Bore hole dia. 8 in. Completion date 12-20-79 Well depth 130 ft.		
Top Soil			0	2	7. <input checked="" type="checkbox"/> Cable tool <input checked="" type="checkbox"/> Rotary <input type="checkbox"/> Driven <input type="checkbox"/> Dug <input type="checkbox"/> Hollow rod <input type="checkbox"/> Jetted <input type="checkbox"/> Bored <input type="checkbox"/> Reverse rotary		
Sandy Clay			2	19	8. Use: <input checked="" type="checkbox"/> Domestic <input type="checkbox"/> Public supply <input type="checkbox"/> Industry <input type="checkbox"/> Irrigation <input type="checkbox"/> Air conditioning <input type="checkbox"/> Stock <input type="checkbox"/> Lawn <input type="checkbox"/> Oil field water <input type="checkbox"/> Other		
Lime			19	19 1/2	9. Casing: Material PL Height: Above or below Threaded <input type="checkbox"/> Welded <input checked="" type="checkbox"/> Surface 18 in. RMP <input type="checkbox"/> PVC <input checked="" type="checkbox"/> Weight <input type="checkbox"/> lbs./ft.		
Sandy Shale			19 1/2	89	Dia. 5 in. to 131 ft. depth Wall Thickness: inches Dia. <input type="checkbox"/> in. to <input type="checkbox"/> ft. depth Gauge No. .265		
Lime Hardball?			89	94	10. Screens: Manufacturer's name (Slotted Pipe) Vinylplex, Inc. Type PVC Dia. 5" Slot/gauze .06 1/16 Length 21 ft. Set between 104 ft. and 125 ft. ft. and <input type="checkbox"/> ft.		
Shale			94	103	Gravel pack? <input checked="" type="checkbox"/> Size range of material 1-4 1-8		
Slate <i>Exleyville Coal?</i>			103	104	11. Static water level: <input type="checkbox"/> mo./day/yr. 45 ft. below land surface Date 12-20-79		
Sandstone			104	125	12. Pumping level below land surfaces: ft. after <input type="checkbox"/> hrs. pumping <input type="checkbox"/> g.p.m. ft. after <input type="checkbox"/> hrs. pumping <input type="checkbox"/> g.p.m. Estimated maximum yield 1 1/2 g.p.m.		
Shale			125	130	13. Water sample submitted: <input type="checkbox"/> mo./day/yr. <input checked="" type="checkbox"/> Yes <input checked="" type="checkbox"/> No Date <input type="checkbox"/>		
					14. Well head completion: <input checked="" type="checkbox"/> Pitless adapter 18 inches above grade		
					15. Well grouted? Yes With: <input checked="" type="checkbox"/> Neat cement <input type="checkbox"/> Bentonite <input type="checkbox"/> Concrete Depth: From 3 ft. to 15 ft.		
					16. Nearest source of possible contamination: ft. 150' Direction NW Type Septic Well disinfected upon completion? <input checked="" type="checkbox"/> Yes <input type="checkbox"/> No		
					17. Pump: <input type="checkbox"/> Not installed Manufacturer's name Jacuzzi Model number 5S4E HP 1/2 Volts 220 Length of drop pipe 120 ft. capacity 10 g.p.m. Type: <input checked="" type="checkbox"/> Submersible <input type="checkbox"/> Turbine <input type="checkbox"/> Jet <input type="checkbox"/> Reciprocating <input type="checkbox"/> Centrifugal <input type="checkbox"/> Other		
18. Elevation: 875 Topography RM <input type="checkbox"/> Hill <input type="checkbox"/> Slope <input type="checkbox"/> Upland <input type="checkbox"/> Valley			19. Remarks:		20. Water well contractor's certification: This well was drilled under my jurisdiction and this report is true to the best of my knowledge and belief. BREUER, INC. 174 Business name License No. Address Box 147, Basehor, Ks. Signed <i>Ray Breuer</i> Date 12-21-79 Authorized representative		