


1	LOCATION OF WATER WELL:	Fraction	Section Number	Township Number	Range Number
	County: <u>Jefferson</u>	$\frac{1}{4}$ SE $\frac{1}{4}$ SE $\frac{1}{4}$ NW	8	11	20 <span style="border: 1px solid black; border-radius: 50%; padding: 2px;">EW</span>

Distance and direction from nearest town or city street address of well if located within city?

5 miles west of Tonganoxie

2	WATER WELL OWNER: <u>Jeffrey B. Rousselo</u>	Board of Agriculture, Division of Water Resources
	RR #, St. Address, Box #: <u>14352 Leavenworth Road</u>	Application Number: _____
	City, State, ZIP Code : <u>Basehor, KS 66007-5235</u>	

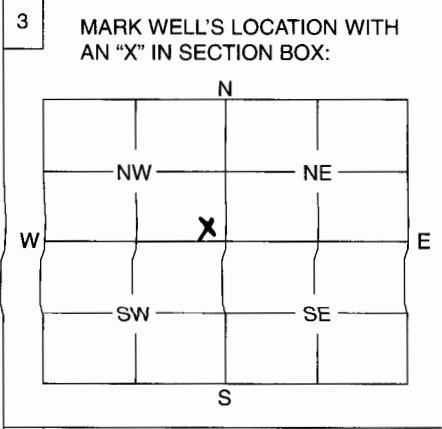

5	TYPE OF BLANK CASING USED: <u>NONE USED</u>				
	1 Steel	3 RMP (SR)	5 Wrought	7 Fiberglass	9 Other (Specify below)
	2 PVC	4 ABS	6 Asbestos-Cement	8 Concrete Tile	.....
	Blank casing diameter ..... in.      Was casing pulled?      Yes .....      No .....      If yes, how much .....				
	Casing height above or below land surface ..... in.				

6	GROUT PLUG MATERIAL:      1 Neat cement      2 Cement grout <u>3 Bentonite</u> 4 Other .....				
	Grout Plug Intervals:      From ..... <u>0</u> ..... ft.      to ..... <u>50</u> ..... ft.,      From ..... ft.      to ..... ft.,      From .....      to ..... ft.				
	What is the nearest source of possible contamination:				
	1 Septic tank	6 Seepage pit	11 Fuel storage	<u>16 Other (specify below)</u>	
	2 Sewer lines	7 Pit privy	12 Fertilizer storage	..... <u>Nothing yet</u> .....	
	3 Watertight sewer lines	8 Sewage lagoon	13 Insecticide storage		
	4 Lateral lines	9 Feedyard	14 Abandoned water well		
	5 Cess pool	10 Livestock pens	15 Oil well/Gas well		
	Direction from well? .....      How many feet? .....				

FROM	TO	PLUGGING MATERIALS
0	50	Bentonite
50	130	Lime Chat

7	CONTRACTOR'S OF LANDOWNER'S CERTIFICATION: This water well was plugged under my jurisdiction and was completed on (mo/day/year) <u>10/24/05</u> ..... and this record is true to the best of my knowledge and belief. Kansas Water Well Contractor's License No. <u>595</u> ..... This Water Well Record was completed on (mo/day/year) <u>11/16/05</u> ..... under the business name of <u>Jesse Yeakum Well Drilling</u> ..... by (signature) <u>Jesse Yeakum</u> .....	
---	---	--

INSTRUCTIONS: Use typewriter or ball point pen. Please press firmly and print clearly. Please fill in blanks, underline or circle the correct answers. Send top three copies to Kansas Department of Health and Environment, Bureau of Water, Geology Section, 1000 SW Jackson St., Ste. 420, Topeka, Kansas 66612-1367. Telephone: 785/296-5522. Send one to Water Well Owner and retain one for your records.