


1 LOCATION OF WATER WELL: Fraction NW 1/4 NW 1/4 NE 1/4 Section Number 12 Township Number T 11 S Range Number R 21 E
 County: Leavenworth

Distance and direction from nearest town or city street address of well if located within city?
19501 State Tompoxie Ks.

2 WATER WELL OWNER: Stranger Township Fire Dept.
 RR#, St. Address, Box #: 21526 211th St. Board of Agriculture, Division of Water Resources
 City, State, ZIP Code: Tompoxie Ks. 66086 Application Number:

3 LOCATE WELL'S LOCATION WITH AN "X" IN SECTION BOX:

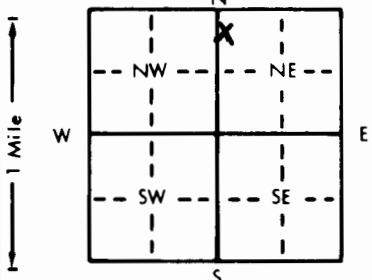

4 DEPTH OF COMPLETED WELL: 100 ft. ELEVATION:

Depth(s) Groundwater Encountered 1. 70-78 ft. 2. ft. 3. ft.
 WELL'S STATIC WATER LEVEL 60 ft. below land surface measured on mo/day/yr Sept 4 97
 Pump test data: Well water was ft. after hours pumping gpm
 Est. Yield 5 gpm Well water was ft. after hours pumping gpm
 Bore Hole Diameter: 8 3/4 in. to 100 ft., and in. to ft.
 WELL WATER TO BE USED AS:
 1 Domestic 3 Feedlot 6 Oil field water supply 9 Dewatering 12 Other (Specify below)
 2 Irrigation 4 Industrial 7 Lawn and garden only 10 Monitoring well
 Was a chemical/bacteriological sample submitted to Department? Yes No If yes, mo/day/yr sample was submitted
 Water Well Disinfected? Yes No

5 TYPE OF BLANK CASING USED:
 1 Steel 3 RMP (SR) 5 Wrought iron 8 Concrete tile CASING JOINTS: Glued Clamped
 2 PVC 4 ABS 6 Asbestos-Cement 9 Other (specify below) Welded
 7 Fiberglass Threaded

Blank casing diameter 5 in. to 90 ft. Dia. in. to ft. Dia. in. to ft.
 Casing height above land surface 30 in. weight 200 PSI lbs./ft. Wall thickness or gauge No.

TYPE OF SCREEN OR PERFORATION MATERIAL:
 1 Steel 3 Stainless steel 5 Fiberglass 7 PVC 10 Asbestos-cement
 2 Brass 4 Galvanized steel 6 Concrete tile 8 RMP (SR) 11 Other (specify)
 9 ABS 12 None used (open hole)

SCREEN OR PERFORATION OPENINGS ARE:
 1 Continuous slot 3 Mill slot 5 Gauzed wrapped 8 Saw cut 11 None (open hole)
 2 Louvered shutter 4 Key punched 6 Wire wrapped 9 Drilled holes
 7 Torch cut 10 Other (specify)

SCREEN-PERFORATED INTERVALS: From 90 ft. to 100 ft. From ft. to ft.
 GRAVEL PACK INTERVALS: From 100 ft. to 54 ft. From 49 ft. to 20 ft.

6 GROUT MATERIAL: 1 Neat cement 2 Cement grout 3 Bentonite 4 Other
 Grout Intervals: From 49 ft. to 54 ft. From 20 ft. to 0 ft. From ft. to ft.

What is the nearest source of possible contamination: NONE AT TIME OF DRILLING
 1 Septic tank 4 Lateral lines 7 Pit privy 10 Livestock pens 14 Abandoned water well
 2 Sewer lines 5 Cess pool 8 Sewage lagoon 11 Fuel storage 15 Oil well/Gas well
 3 Watertight sewer lines 6 Seepage pit 9 Feedyard 12 Fertilizer storage 16 Other (specify below)
 13 Insecticide storage

Direction from well? How many feet?

FROM	TO	LITHOLOGIC LOG	FROM	TO	PLUGGING INTERVALS
0	10	Sandstone			
10	25	Shale			
25	35	Sandstone			
35	45	Shale			
45	58	Sandstone fine grained			
58	63	Sandstone medium grained			
63	70	Sandstone fine grained			
70	78	Sandstone large grained			
78	82	Limestone			
82	85	Shale			
85	90	Limestone			
90	100	Shale			

7 CONTRACTOR'S OR LANDOWNER'S CERTIFICATION: This water well was constructed, reconstructed, or plugged under my jurisdiction and was completed on (mo/day/year) Sept 4 1997 and this record is true to the best of my knowledge and belief. Kansas Water Well Contractor's License No. 561 This Water Well Record was completed on (mo/day/yr) Sept 5 1997 under the business name of EVANS Energy Dev. Inc. by (signature) [Signature]

OFFICE USE ONLY
T
R
EW
SEC.