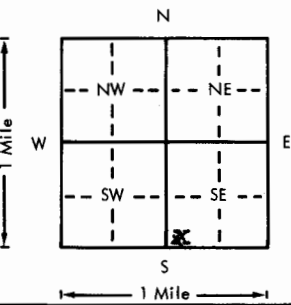


USE TYPEWRITER OR BALL POINT PEN—PRESS FIRMLY, PRINT CLEARLY.

WATER WELL RECORD
KSA 82a-1201-1215

Kansas Department of Health and Environment—Division of Environment (Water well Contractors)
Topeka, Kansas 66620

1. Location of well:	County Leavenworth	Fraction SW 1/4 SW 1/4 SE 1/4	Section number 1	Township number T 11 S	Range number R 21 (E/W)
2. Distance and direction from nearest town or city: 2 1/2 miles east Street address of well location if in city: of Tonganoxie, Kansas			3. Owner of well: Jack Kelly - former owner R.R. or street: Route 3 City, state, zip code: Tonganoxie, Kansas		
4. Locate with "X" in section below: Sketch map: 			6. Bore hole dia. 8 in. Completion date 10-6-76 Well depth 75 ft.		
5. Type and color of material			7. <input type="checkbox"/> Cable tool <input checked="" type="checkbox"/> Rotary <input type="checkbox"/> Driven <input type="checkbox"/> Dug <input type="checkbox"/> Hollow rod <input type="checkbox"/> Jetted <input type="checkbox"/> Bored <input type="checkbox"/> Reverse rotary		
			8. Use: <input checked="" type="checkbox"/> Domestic <input type="checkbox"/> Public supply <input type="checkbox"/> Industry <input type="checkbox"/> Irrigation <input type="checkbox"/> Air conditioning <input type="checkbox"/> Stock <input type="checkbox"/> Lawn <input type="checkbox"/> Oil field water <input type="checkbox"/> Other		
			9. Casing: Material <u>PL</u> Height: Above or below Threaded <input type="checkbox"/> Welded <input checked="" type="checkbox"/> Surface <u>18</u> in. RMP <input type="checkbox"/> PVC <input checked="" type="checkbox"/> Weight <u> </u> lbs./ft. Dia. <u>0</u> in. to <u>77</u> ft. depth! Wall thickness: inches or Dia. <u> </u> in. to <u> </u> ft. depth! gage No. <u>258</u>		
			10. Screen: Manufacturer's name (Slotted Pipe) Vinylplex, Inc. Type <u>PVC</u> Dia. <u> </u> Slot/gauze <u>06 1/16</u> Length <u> </u> Set between <u>44</u> ft. and <u>69</u> ft. <u> </u> ft. and <u> </u> ft. Gravel pack? <input checked="" type="checkbox"/> Size range of material <u>1/4 - 1/8</u>		
			11. Static water level: <u> </u> mo./day/yr. <u>25</u> ft. below land surface Date 10-6-76		
			12. Pumping level below land surfaces: <u> </u> ft. after <u> </u> hrs. pumping <u> </u> g.p.m. <u> </u> ft. after <u> </u> hrs. pumping <u> </u> g.p.m. Estimated maximum yield <u>30</u> g.p.m.		
			13. Water sample submitted: <u> </u> mo./day/yr. <input type="checkbox"/> Yes <input checked="" type="checkbox"/> No Date <u> </u>		
14. Well head completion: NONE <input type="checkbox"/> Pitless adapter <u> </u> inches above grade					
15. Well grouted? Yes With: <input checked="" type="checkbox"/> Neat cement <input type="checkbox"/> Bentonite <input type="checkbox"/> Concrete Depth: From <u>3</u> ft. to <u>23</u> ft.					
16. Nearest source of possible contamination: ft. <u>100!</u> Direction East Type Septic Well disinfected upon completion? <input checked="" type="checkbox"/> Yes <input type="checkbox"/> No					
17. Pump: <input checked="" type="checkbox"/> Not installed Manufacturer's name <u> </u> Model number <u> </u> HP <u> </u> Volts <u> </u> Length of drop pipe <u> </u> ft. capacity <u> </u> g.p.m. Type: <input type="checkbox"/> Submersible <input type="checkbox"/> Turbine <input type="checkbox"/> Jet <input type="checkbox"/> Reciprocating <input type="checkbox"/> Centrifugal <input type="checkbox"/> Other					
(Use a second sheet if needed)					
18. Elevation: 855 Topography: <input type="checkbox"/> Hill <input type="checkbox"/> Slope <input type="checkbox"/> Upland <input type="checkbox"/> Valley	19. Remarks:		20. Water well contractor's certification: This well was drilled under my jurisdiction and this report is true to the best of my knowledge and belief. BREUER, INC. License No. 174 Business name <u>Box 147 Basgord</u> License No. <u> </u> Address <u> </u> Ks. Signed <u> </u> Date Oct. 6, 1976 Authorized representative		

Forward the white, blue and pink copies to the Department of Health and Environment

Form WWC-5

BR elev = 835 ∇ = 730

T
R
W
S
E