


1 LOCATION OF WATER WELL: County: Leavenworth Fraction SW 1/4 ne 1/4 SW 1/4 Section Number 4 Township Number T 11s S Range Number R 21e E/W

Distance and direction from nearest town or city street address of well if located within city? 1/2 mile due north of Tonganoxie, KS

2 WATER WELL OWNER: Mike & Nancy Gibbens RR#, St. Address, Box #: Tonganoxie, KS 66086 Board of Agriculture, Division of Water Resources Application Number:

3 LOCATE WELL'S LOCATION WITH AN "X" IN SECTION BOX:

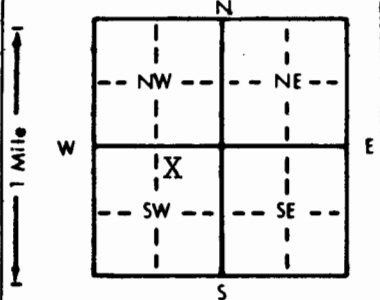

4 DEPTH OF COMPLETED WELL: 75 ft. ELEVATION: Depth(s) Groundwater Encountered 1. 34 ft. 2. ft. 3. ft. WELL'S STATIC WATER LEVEL 20 ft. below land surface measured on mo/day/yr 7-15-92

Pump test data: Well water was ... ft. after ... hours pumping ... gpm Est. Yield 4 gpm: Well water was ... ft. after ... hours pumping ... gpm Bore Hole Diameter 12 in. to 20 ft., and ... in. to ... ft. WELL WATER TO BE USED AS: #1 5 Public water supply 8 Air conditioning 11 Injection well 1 Domestic 3 Feedlot 6 Oil field water supply 9 Dewatering 12 Other (Specify below) 2 Irrigation 4 Industrial 7 Lawn and garden only 10 Monitoring well Was a chemical/bacteriological sample submitted to Department? Yes No X; If yes, mo/day/yr sample was submitted Water Well Disinfected? Yes X No

5 TYPE OF BLANK CASING USED: #2 5 Wrought iron 8 Concrete tile CASING JOINTS: Glued X Clamped 1 Steel 3 RMP (SR) 6 Asbestos-Cement 9 Other (specify below) Welded 2 PVC 4 ABS 7 Fiberglass Threaded

Blank casing diameter 5 in. to 34 ft., Dia 5 in. to 44-72 ft., Dia in. to ft. Casing height above land surface 24 in., weight 265 lbs./ft. Wall thickness or gauge No. 285

TYPE OF SCREEN OR PERFORATION MATERIAL: #7 7 PVC 10 Asbestos-cement 1 Steel 3 Stainless steel 5 Fiberglass 8 RMP (SR) 11 Other (specify) 2 Brass 4 Galvanized steel 6 Concrete tile 9 ABS 12 None used (open hole)

SCREEN OR PERFORATION OPENINGS ARE: #3 5 Gauzed wrapped 8 Saw cut 11 None (open hole) 1 Continuous slot 3 Mill slot 6 Wire wrapped 9 Drilled holes 2 Louvered shutter 4 Key punched 7 Torch cut 10 Other (specify)

SCREEN-PERFORATED INTERVALS: From 34-44 ft. to ft., From ft. to ft. From 72 ft. to 75 ft., From ft. to ft. GRAVEL PACK INTERVALS: From 24 ft. to 75 ft., From ft. to ft. From ft. to ft.

6 GROUT MATERIAL: #3 1 Neat cement 2 Cement grout 3 Bentonite 4 Other Grout Intervals: From 4 ft. to 24 ft., From ft. to ft., From ft. to ft.

What is the nearest source of possible contamination: #1 10 Livestock pens 14 Abandoned water well 1 Septic tank 4 Lateral lines 7 Pit privy 11 Fuel storage 15 Oil well/Gas well 2 Sewer lines 5 Cess pool 8 Sewage lagoon 12 Fertilizer storage 16 Other (specify below) 3 Watertight sewer lines 6 Seepage pit 9 Feedyard 13 Insecticide storage

Direction from well? southeast How many feet? 200

Table with columns: FROM, TO, LITHOLOGIC LOG, FROM, TO, PLUGGING INTERVALS. Rows include: 0-2 Top Soil, 2-34 Silty soil, 34-44 Gravel, 44-75 Shale.

7 CONTRACTOR'S OR LANDOWNER'S CERTIFICATION: This water well was (1) constructed, (2) reconstructed, or (3) plugged under my jurisdiction and was completed on (mo/day/year) #1 7-15-92 and this record is true to the best of my knowledge and belief. Kansas Water Well Contractor's License No. 174 This Water Well Record was completed on (mo/day/yr) 7-29-92 under the business name of Breuer INC. by (signature)