

262

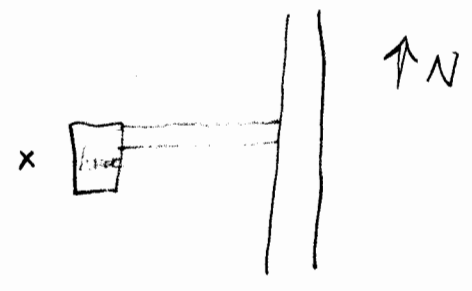
52011796

USE TYPEWRITER OR BALL
POINT PEN-PRESS FIRMLY,
PRINT CLEARLY.

WATER WELL RECORD
KSA 82a-1201-1215

Kansas Department of Health and
Environment-Division of Environment
(Water well Contractors)
Topeka, Kansas 66620

NE
CE 1/4 - NW 1/4 SE 1/4

1. Location of well:		County Leavenworth	Fraction NE 1/4 SE 1/4 SE 1/4 1/4 SE 1/4 SE 1/4	Section number 15	Township number T 11 S R 21	Range number 21 E/W
2. Distance and direction from nearest town or city: 1 mile south of Tonganoxie, Kansas			3. Owner of well: Richard Thomas R.R. or street: Box 433 1211 Spruce City, state, zip code: Eudora, Kansas 66025			
4. Locate with "X" in section below: N W E S 1 Mile		Sketch map: 		6. Bore hole dia. 8 in. Completion date 6-6-77 Well depth 120 ft.		
5. Type and color of material		From To		7. Cable tool <input checked="" type="checkbox"/> Rotary <input type="checkbox"/> Driven <input type="checkbox"/> Dug <input type="checkbox"/> Hollow rod <input type="checkbox"/> Jetted <input type="checkbox"/> Bored <input type="checkbox"/> Reverse rotary		
				8. Use: <input checked="" type="checkbox"/> Domestic <input type="checkbox"/> Public supply <input type="checkbox"/> Industry <input type="checkbox"/> Irrigation <input type="checkbox"/> Air conditioning <input type="checkbox"/> Stock <input type="checkbox"/> Lawn <input type="checkbox"/> Oil field water <input type="checkbox"/> Other		
				9. Casing: Material PL Height: Above or below Threaded <input type="checkbox"/> Welded <input checked="" type="checkbox"/> Surface 18 in. RMP <input type="checkbox"/> PVC <input checked="" type="checkbox"/> Weight <input type="checkbox"/> lbs./ft. Dia. 5 in. to 101 ft. depth Wall Thickness: inches or Dia. <input type="checkbox"/> in. to <input type="checkbox"/> ft. depth gage No. 265		
				10. Screen: Manufacturer's name (Slotted Pipe) Vinylplex, Inc. Type PVC Dia. 5" Slot/gauze .06 1/16 Length 15 ft. Set between 90 ft. and 105 ft. <input type="checkbox"/> ft. and <input type="checkbox"/> ft. Gravel pack? <input checked="" type="checkbox"/> Size range of material 1/4 - 1/8		
				11. Static water level: 1360 ft. below land surface Date 6-6-77		
Sandy Top Soil		0	1	12. Pumping level below land surfaces: <input type="checkbox"/> ft. after <input type="checkbox"/> hrs. pumping <input type="checkbox"/> g.p.m. <input type="checkbox"/> ft. after <input type="checkbox"/> hrs. pumping <input type="checkbox"/> g.p.m. Estimated maximum yield 75 g.p.m.		
Clay - Yellow		1	15	13. Water sample submitted: <input checked="" type="checkbox"/> Yes <input type="checkbox"/> No Date <input type="checkbox"/>		
Shale - Blue		15	25	14. Well head completion: <input checked="" type="checkbox"/> Pitless adapter 18 inches above grade		
Sandstone - Yellow		25	26	15. Well grouted? Yes With: <input checked="" type="checkbox"/> Neat cement <input type="checkbox"/> Bentonite <input type="checkbox"/> Concrete Depth: From 3 ft. to 15 ft.		
Sandy Shale - Blue <i>sulfur</i>		26	29	16. Nearest source of possible contamination: ft. 75 Direction north Type Septic Well disinfected upon completion? <input checked="" type="checkbox"/> Yes <input type="checkbox"/> No		
Sandstone - Yellow <i>iron</i>		29	42	17. Pump: Manufacturer's name Jacuzzi Model number 5SLB HP 1/2 Volts 220 Length of drop pipe 115 ft. capacity 10 g.p.m. Type: <input checked="" type="checkbox"/> Submersible <input type="checkbox"/> Turbine <input type="checkbox"/> Jet <input type="checkbox"/> Reciprocating <input type="checkbox"/> Centrifugal <input type="checkbox"/> Other		
Sandy Shale - Blue <i>soft water</i>		42	44	20. Water well contractor's certification: This well was drilled under my jurisdiction and this report is true to the best of my knowledge and belief. BREUER, INC. Box 147 Business name License No. Address Basehor, Ks 174 Signed <i>[Signature]</i> Date 6-14-77		
Sandstone - Gray		44	101			
Lime		101	102			
Sandstone - Soft		102	104			
Lime		104	109			
Slate		109	114			
Lime		114	119			
Shale		119	120			
(Use a second sheet if needed)						
18. Elevation: 881 Topography: <input type="checkbox"/> Hill <input type="checkbox"/> Slope <input type="checkbox"/> Upland <input type="checkbox"/> Valley		19. Remarks:				

Forward the white, blue and pink copies to the Department of Health and Environment

Form WWC-5