266

USE TYPEWRITER OR BALL POINT PEN-PRESS FIRMLY, PRINT CLEARLY.

WATER WELL RECORD
KSA 82a-1201-1215

Kansas Department of Health and Environment-Division of Environment
(Water well Contractors)
Topeka, Kansas 66620

| 1. Location of well: | County | Fraction | Section number | Township number | Range number |
|---|---|---|---|---|---|
| | Leavenworth | NW 1/4 SW 1/4 NW 1/4 | 15 | T 11 S | R 21 (E) W |

2. Distance and direction from nearest town or city: 1/2 mile SE
Street address of well location if in city: Tonganoxie

3. Owner of well: H. G. Kelly
R.R. or street: 8545 Sandusky
City, state, zip code: Kansas City, Kansas

4. Locate with "X" in section below:

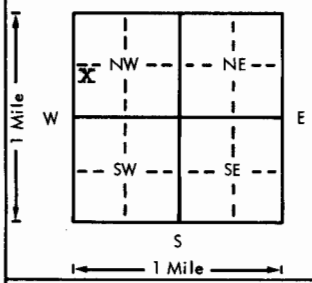


Sketch map:

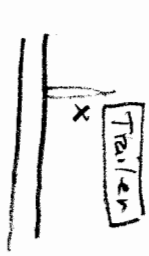


6. Bore hole dia. 8 in. Completion date 11/13/75
Well depth 140 ft.

7. __ Cable tool X Rotary __ Driven __ Dug
__ Hollow rod __ Jetted __ Bored __ Reverse rotary

8. Use: X Domestic __ Public supply __ Industry
__ Irrigation __ Air conditioning __ Stock
__ Lawn __ Oil field water __ Other

9. Casing: Material PL. Height: Above or below
Threaded ___ Welded X Surface 18 in.
RMP ___ PVC X Weight ___ lbs./ft.
Dia. 5 in. to 40 ft. depth Wall Thickness: inches or
Dia. ___ in. to ___ ft. depth gage No. .258

10. Screen: Manufacturer's name No screen pipe cemented from 40' to top
Type ___ Dia. ___
Slot/gauze ___ Length ___
Set between ___ ft. and ___ ft.
___ ft. and ___ ft.
Gravel pack? No Size range of material ___

11. Static water level: 60 ft. below land surface Date 11/13/75 (mo./day/yr.)

12. Pumping level below land surfaces:
___ ft. after ___ hrs. pumping ___ g.p.m.
___ ft. after ___ hrs. pumping ___ g.p.m.
Estimated maximum yield over 15 g.p.m.

13. Water sample submitted: ___ Yes X No Date ___ (mo./day/yr.)

14. Well head completion:
X Pitless adapter 18 Inches above grade

15. Well grouted? Yes
With: X Neat cement ___ Bentonite ___ Concrete
Depth: From 3 ft. to 38 ft.

16. Nearest source of possible contamination:
ft. 155 Direction North Type Barnyard
Well disinfected upon completion? X Yes ___ No

17. Pump: ___ Not installed
Manufacturer's name Jacuzzi
Model number 5S4B HP 1/2 Volts 220
Length of drop pipe 100 ft. capacity 10 g.p.m.
Type:
X Submersible ___ Turbine
___ Jet ___ Reciprocating
___ Centrifugal ___ Other

| 5. Type and color of material | From | To |
|---|---|---|
| Top Soil | 0 | 1 |
| Clay - Yellow | 1 | 4 |
| Sandstone - Yellow | 4 | 21 |
| Sandy Shale - Gray | 21 | 34 |
| Sandstone - Gray | 34 | 53 |
| Lime - White | 53 | 54 |
| Sandstone - Yellow | 54 | 74 |
| Sandstone - Gray | 74 | 140 |

(Use a second sheet if needed)

18. Elevation: 920 ft
Topography:
___ Hill
X Slope
___ Upland
___ Valley

19. Remarks: Very Good Well

20. Water well contractor's certification:
This well was drilled under my jurisdiction and this report is true to the best of my knowledge and belief.
BREUER DRILLING CO. 174
Business name License No.
Address Box 174 147 Basehor, Ks.
Signed [signature] Authorized representative Date 12/16/75

Forward the white, blue and pink copies to the Department of Health and Environment

Form WWC-5

T 11 R 21 (E) W Sec 15 1/4 NW 1/4 SW 1/4 NW