


1 LOCATION OF WATER WELL: County: Leavenworth Fraction: NW 1/4 SE 1/4 Section Number: 15 Township Number: T 11 S Range Number: R 21 EW

Distance and direction from nearest town or city street address of well if located within city?  
2 miles east 1 south.

2 WATER WELL OWNER: Heaven HOLTON.  
 RR#, St. Address, Box # : \_\_\_\_\_ Board of Agriculture, Division of Water Resources  
 City, State, ZIP Code : \_\_\_\_\_ Application Number: \_\_\_\_\_

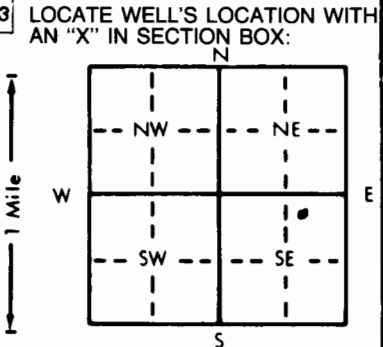

4 DEPTH OF COMPLETED WELL: 115 ft. ELEVATION: \_\_\_\_\_  
 Depth(s) Groundwater Encountered 1. 90 ft. 2. \_\_\_\_\_ ft. 3. \_\_\_\_\_ ft.  
 WELL'S STATIC WATER LEVEL 50 ft. below land surface measured on mo/day/yr 9-30-89  
 Pump test data: Well water was \_\_\_\_\_ ft. after \_\_\_\_\_ hours pumping \_\_\_\_\_ gpm  
 Est. Yield 107 gpm: Well water was \_\_\_\_\_ ft. after \_\_\_\_\_ hours pumping \_\_\_\_\_ gpm  
 Bore Hole Diameter 8 in. to 115 ft., and \_\_\_\_\_ in. to \_\_\_\_\_ ft.  
 WELL WATER TO BE USED AS:  
 1 Domestic     3 Feedlot     6 Oil field water supply     9 Dewatering     11 Injection well  
 2 Irrigation     4 Industrial     7 Lawn and garden only     10 Monitoring well  
 5 Public water supply     8 Air conditioning     12 Other (Specify below)

Was a chemical/bacteriological sample submitted to Department? Yes \_\_\_\_\_ No ; If yes, mo/day/yr sample was submitted \_\_\_\_\_  
 Water Well Disinfected? Yes  No \_\_\_\_\_

5 TYPE OF BLANK CASING USED:  
 1 Steel     3 RMP (SR)     5 Wrought iron     8 Concrete tile    CASING JOINTS: Glued  Clamped \_\_\_\_\_  
 2 PVC     4 ABS     6 Asbestos-Cement     9 Other (specify below)    Welded \_\_\_\_\_  
 7 Fiberglass    Threaded \_\_\_\_\_  
 Blank casing diameter \_\_\_\_\_ in. to \_\_\_\_\_ ft., Dia \_\_\_\_\_ in. to \_\_\_\_\_ ft., Dia \_\_\_\_\_ in. to \_\_\_\_\_ ft.  
 Casing height above land surface 18 in., weight \_\_\_\_\_ lbs./ft. Wall thickness or gauge No. \_\_\_\_\_  
 TYPE OF SCREEN OR PERFORATION MATERIAL:  
 1 Steel     3 Stainless steel     5 Fiberglass     7 PVC     10 Asbestos-cement  
 2 Brass     4 Galvanized steel     6 Concrete tile     8 RMP (SR)     11 Other (specify) \_\_\_\_\_  
 9 ABS     12 None used (open hole)  
 SCREEN OR PERFORATION OPENINGS ARE:  
 1 Continuous slot     3 Mill slot     5 Gauzed wrapped     8 Saw cut     11 None (open hole)  
 2 Louvered shutter     4 Key punched     6 Wire wrapped     9 Drilled holes  
 7 Torch cut     10 Other (specify) \_\_\_\_\_  
 SCREEN-PERFORATED INTERVALS: From 75 ft. to 115 ft., From \_\_\_\_\_ ft. to \_\_\_\_\_ ft.  
 From \_\_\_\_\_ ft. to \_\_\_\_\_ ft., From \_\_\_\_\_ ft. to \_\_\_\_\_ ft.  
 GRAVEL PACK INTERVALS: From 9 ft. to 40 ft., From \_\_\_\_\_ ft. to \_\_\_\_\_ ft.  
 From 45 ft. to 115 ft., From \_\_\_\_\_ ft. to \_\_\_\_\_ ft.

6 GROUT MATERIAL:  1 Neat cement     2 Cement grout     3 Bentonite     4 Other \_\_\_\_\_  
 Grout Intervals: From 4 ft. to 9 ft., From 40 ft. to 45 ft., From \_\_\_\_\_ ft. to \_\_\_\_\_ ft.  
 What is the nearest source of possible contamination:  
 1 Septic tank     4 Lateral lines     7 Pit privy     10 Livestock pens     14 Abandoned water well  
 2 Sewer lines     5 Cess pool     8 Sewage lagoon     11 Fuel storage     15 Oil well/Gas well  
 3 Watertight sewer lines     6 Seepage pit     9 Feedyard     12 Fertilizer storage     16 Other (specify below)  
 13 Insecticide storage \_\_\_\_\_  
 Direction from well? east How many feet? 100

FROM	TO	LITHOLOGIC LOG	FROM	TO	PLUGGING INTERVALS
0	1	Top soil.			
1	20	Brown sandrock			
20	30	Gray shale.			
30	90	Sandy shale.			
90	113	White sand.			
113	115	Loam.			
		T.D. 115			

7 CONTRACTOR'S OR LANDOWNER'S CERTIFICATION: This water well was  (1) constructed,  (2) reconstructed, or  (3) plugged under my jurisdiction and was completed on (mo/day/year) 9-30-89 and this record is true to the best of my knowledge and belief. Kansas Water Well Contractor's License No. 212 This Water Well Record was completed on (mo/day/yr) 11-6-89 under the business name of Schuf Drilling by (signature) Kenneth Schuf

OFFICE USE ONLY

T

R

EW

SEC.

1/4

1/4

1/4