

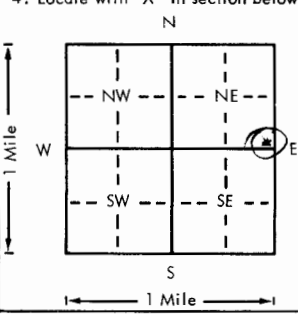
140

R
BRT

USE TYPEWRITER OR BALL POINT PEN-PRESS FIRMLY, PRINT CLEARLY.

WATER WELL RECORD
KSA 82a-1201-1215

Kansas Department of Health and Environment-Division of Environment
(Water well Contractors)
Topeka, Kansas 66620

1. Location of well:		County Leavenworth	Fraction SE 1/4 SE 1/4 NE 1/4	Section number 22	Township number T 11 S R 21	Range number 21
2. Distance and direction from nearest town or city: 1 1/2 miles SE of Tonganoxie, Ks.			3. Owner of well: Mr. Richard Chapman R.R. or street: P. O. Box 424 City, state, zip code: Tonganoxie, Kansas			
4. Locate with "X" in section below: 			Sketch map:		6. Bore hole dia. <u>8</u> in. Completion date 10-13-78 Well depth 150 ft.	
5. Type and color of material			From	To	7. <input checked="" type="checkbox"/> Cable tool <input checked="" type="checkbox"/> Rotary <input type="checkbox"/> Driven <input type="checkbox"/> Dug <input type="checkbox"/> Hollow rod <input type="checkbox"/> Jetted <input type="checkbox"/> Bored <input type="checkbox"/> Reverse rotary	
Top Soil			0	1	8. Use: <input checked="" type="checkbox"/> Domestic <input type="checkbox"/> Public supply <input type="checkbox"/> Industry <input type="checkbox"/> Irrigation <input type="checkbox"/> Air conditioning <input type="checkbox"/> Stock <input type="checkbox"/> Lawn <input type="checkbox"/> Oil field water <input type="checkbox"/> Other	
Clay			1	13	9. Casing: Material PL Height: Above or below Threaded <input type="checkbox"/> Welded <input checked="" type="checkbox"/> Surface <u>18</u> in. RMP <input type="checkbox"/> PVC <input checked="" type="checkbox"/> Weight _____ lbs./ft. Dia. <u>5</u> in. to <u>152</u> ft. depth Wall Thickness _____ inches or Dia. _____ in. to _____ ft. depth Gage No. <u>.265</u>	
Lime			13	17	10. Screen: Manufacturer's name (Slotted Pipe) Vinylplex, Inc. Type PVC Dia. 5" Slot/gauze .06 1/16 Length 26' Set between 120 ft. and 146 ft. _____ ft. and _____ ft. Gravel pack? <input checked="" type="checkbox"/> Size range of material 1/4 - 1/8	
Shale			17	19	11. Static water level: _____ mo./day/yr. 65 ft. below land surface Date 10-13-78	
Lime			19	20	12. Pumping level below land surfaces: _____ ft. after _____ hrs. pumping _____ g.p.m. _____ ft. after _____ hrs. pumping _____ g.p.m. Estimated maximum yield 20 g.p.m.	
Shale			20	100	13. Water sample submitted: _____ mo./day/yr. Yes <input checked="" type="checkbox"/> No <input type="checkbox"/> Date _____	
Sandy Shale			100	120	14. Well head completion: <input checked="" type="checkbox"/> Pitless adapter <u>18</u> Inches above grade	
Sandstone			120	146	15. Well grouted? Yes With: <input checked="" type="checkbox"/> Neat cement <input type="checkbox"/> Bentonite <input type="checkbox"/> Concrete Depth: From <u>3</u> ft. to <u>15</u> ft.	
Lime			146	150	16. Nearest source of possible contamination: ft. <u>200'</u> Direction <u>SE</u> Type <u>Septic</u> Well disinfected upon completion? <input checked="" type="checkbox"/> Yes <input type="checkbox"/> No	
					17. Pump: _____ Not installed Manufacturer's name Jacuzzi Model number 7S4B HP 3/4 Volts 220 Length of drop pipe 140 ft. capacity _____ g.p.m. Type: <input checked="" type="checkbox"/> Submersible <input type="checkbox"/> Turbine <input type="checkbox"/> Jet <input type="checkbox"/> Reciprocating <input type="checkbox"/> Centrifugal <input type="checkbox"/> Other	
			(Use a second sheet if needed)			
18. Elevation: 958 Topography: <input type="checkbox"/> Hill <input type="checkbox"/> Slope <input type="checkbox"/> Upland <input type="checkbox"/> Valley		19. Remarks: 912 RM 2000 wgp		20. Water well contractor's certification: This well was drilled under my jurisdiction and this report is true to the best of my knowledge and belief. BREUER, INC. 174 Business name Box 147, Basehor, Ks. License No. _____ Address _____ Signed Raymond H. Breuer Date 10/20/78 Authorized Representative		

T
R
W
Sec
1/4
1/4
SE
SE
NE

Forward the white, blue and pink copies to the Department of Health and Environment

Form WWC-5

BR elev = 955
899
= 903