269

R
BRT

USE TYPEWRITER OR BALL POINT PEN-PRESS FIRMLY, PRINT CLEARLY.

NW
SW
C½ - SW¼ - NW¼

WATER WELL RECORD
KSA 82a-1201-1215

Kansas Department of Health and Environment-Division of Environment
(Water well Contractors)
Topeka, Kansas 66620

1. Location of well:	County	Fraction	Section number	Township number	Range number
	Leavenworth	~~NW~~ 1/4 SW 1/4 NW 1/4	26	T 11 S	R 21 E/W

2. Distance and direction from nearest town or city: 1 mile east & 2 miles south of Tonganoxie, Kansas
Street address of well location if in city:

3. Owner of well: Russell Walters
R.R. or street: 5438 Webster
City, state, zip code: Kansas City, Kansas

4. Locate with "X" in section below:

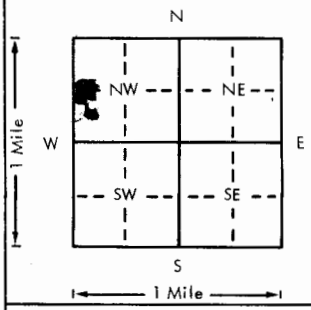

Sketch map:

6. Bore hole dia. 8 in. Completion date 7-12-79
Well depth 130 ft.

7. X Cable tool __ Rotary __ Driven __ Dug
__ Hollow rod __ Jetted __ Bored __ Reverse rotary

8. Use: X Domestic __ Public supply __ Industry
__ Irrigation __ Air conditioning __ Stock
__ Lawn __ Oil field water __ Other

9. Casing: Material PL. Height: Above or below
Threaded ___ Welded X Surface ___ 18 in.
RMP ___ PVC XX Weight ___ lbs./ft.
Dia. 5 in. to 131 ft. depth Wall Thickness: inches or
Dia. ___ in. to ___ ft. depth gage No. .265

10. Screen: Manufacturer's name (Slotted Pipe) Vinylplex, Inc.
Type PVC Dia. 5"
Slot/gauze .06 1/16 Length 40 ft.
Set between 20 ft. and 30 ft.
90 ft. and 120 ft.
Gravel pack? X Size range of material 1/4 - 1/8

5. Type and color of material	From	To
Top Soil	0	3
Sandy Clay	3	12
Lime	12	23
Sandstone	23	32
Shale	32	95
Sandy Shale	95	102
Sandstone	102	110
Lime	110	130

(Use a second sheet if needed)

11. Static water level: mo./day/yr.
17 ft. below land surface Date 7-12-79

12. Pumping level below land surfaces:
___ ft. after ___ hrs. pumping ___ g.p.m.
___ ft. after ___ hrs. pumping ___ g.p.m.
Estimated maximum yield 1 1/2 g.p.m.

13. Water sample submitted: mo./day/yr.
__ Yes X No Date ___

14. Well head completion:
X Pitless adapter 18 Inches above grade

15. Well grouted? Yes
With: X Neat cement ___ Bentonite ___ Concrete
Depth: From 3 ft. to 15 ft.

16. Nearest source of possible contamination:
ft. 200 Direction west Type septic
Well disinfected upon completion? X Yes ___ No

17. Pump: ___ Not installed
Manufacturer's name Jacuzzi
Model number 7S4B HP 1X2 Volts 220
Length of drop pipe 120 ft. capacity 10 g.p.m.
Type:
XXX Submersible ___ Turbine
___ Jet ___ Reciprocating
___ Centrifugal ___ Other

18. Elevation: as 872
Topography:
___ Hill
___ Slope
___ Upland
___ Valley

19. Remarks:

20. Water well contractor's certification:
This well was drilled under my jurisdiction and this report is true to the best of my knowledge and belief.
BREUER, INC. 174
Business name License No.
Address Box 147 Basehor, Ks.
Signed Allen Breuer Date 7-12-79
Authorized representative

T 11 R 21 W Sec 26 NW SW NW 1/4 1/4 1/4

Forward the white, blue and pink copies to the Department of Health and Environment

Form WWC-5

M1-1023