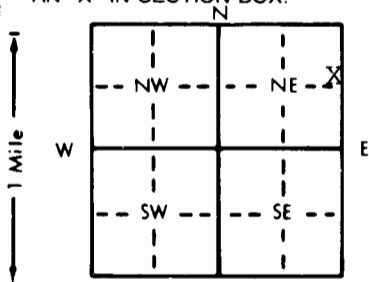


1 LOCATION OF WATER WELL: County: LEAVENWORTH Fraction: SE 1/4 NE 1/4 NE 1/4 Section Number: 21 Township Number: T 11 S Range Number: R 21 E/W

Distance and direction from nearest town or city street address of well if located within city?
1 1/2 miles south of Tonganoxie

2 WATER WELL OWNER: Mark Elston
 RR#, St. Address, Box #: 21589 Kansas Ave. Breuer job
 City, State, ZIP Code: Tonganoxie, KS 66086
 Board of Agriculture, Division of Water Resources
 Application Number:

3 LOCATE WELL'S LOCATION WITH AN "X" IN SECTION BOX:

 4 DEPTH OF COMPLETED WELL: 160' ft. ELEVATION:
 Depth(s) Groundwater Encountered 1. ft. 2. ft. 3. ft.
 WELL'S STATIC WATER LEVEL ... 85' ft. below land surface measured on mo/day/yr 04/16/98
 Pump test data: Well water was ft. after hours pumping gpm
 Est. Yield ... 30 gpm: Well water was ft. after hours pumping gpm
 Bore Hole Diameter ... 8. 3/4 in. to ft., and in. to ft.
 WELL WATER TO BE USED AS: 5 Public water supply 8 Air conditioning 11 Injection well
 1 Domestic 3 Feedlot 6 Oil field water supply 9 Dewatering 12 Other (Specify below)
 2 Irrigation 4 Industrial 7 Lawn and garden only 10 Monitoring well
 Was a chemical/bacteriological sample submitted to Department? Yes..... No..... X.....; If yes, mo/day/yr sample was submitted
 Water Well Disinfected? Yes X No

5 TYPE OF BLANK CASING USED:
 1 Steel 3 RMP (SR) 5 Wrought iron 8 Concrete tile CASING JOINTS: Glued ... X ... Clamped ...
 2 PVC 4 ABS 6 Asbestos-Cement 9 Other (specify below) Welded ...
 7 Fiberglass Threaded ...
 Blank casing diameter ... 5" in. to ... 0-120 ft., Dia ... in. to ... ft., Dia ... in. to ... ft.
 Casing height above land surface ... 24" in., weight ... 2.82 lbs./ft. Wall thickness or gauge No. ... 258
 TYPE OF SCREEN OR PERFORATION MATERIAL:
 1 Steel 3 Stainless steel 5 Fiberglass 7 PVC 10 Asbestos-cement
 2 Brass 4 Galvanized steel 6 Concrete tile 8 RMP (SR) 11 Other (specify) ...
 12 None used (open hole)
 SCREEN OR PERFORATION OPENINGS ARE:
 1 Continuous slot 3 Mill slot 5 Gauzed wrapped 8 Saw cut 11 None (open hole)
 2 Louvered shutter 4 Key punched 6 Wire wrapped 9 Drilled holes
 7 Torch cut 10 Other (specify) ...
 SCREEN-PERFORATED INTERVALS: From ... 120 ft. to ... 160 ft., From ... ft. to ... ft.
 From ... ft. to ... ft., From ... ft. to ... ft.
 GRAVEL PACK INTERVALS: From ... 24 ft. to ... 160 ft., From ... ft. to ... ft.
 From ... ft. to ... ft., From ... ft. to ... ft.

6 GROUT MATERIAL: 1 Neat cement 2 Cement grout 3 Bentonite 4 Other
 Grout Intervals: From ... 4 ft. to ... 24 ft., From ... ft. to ... ft., From ... ft. to ... ft.
 What is the nearest source of possible contamination:
 1 Septic tank 4 Lateral lines 7 Pit privy 10 Livestock pens 14 Abandoned water well
 2 Sewer lines 5 Cess pool 8 Sewage lagoon 11 Fuel storage 15 Oil well/Gas well
 3 Watertight sewer lines 6 Seepage pit 9 Feedyard 12 Fertilizer storage 16 Other (specify below)
 13 Insecticide storage
 Direction from well? east How many feet? 200'

FROM	TO	LITHOLOGIC LOG	FROM	TO	PLUGGING INTERVALS
0	6	Clay-Brown			
6	16	Shale-Yellow			
16	17	Limestone-Tan			
17	25	Sandy Shale-Grey			
25	27	Limestone-Tan			
27	52	Sandy Shale-Grey			
52	57	Shaley LS-Grey			
57	63	Sandstone-Grey			
63	72	Shale-Grey			
72	125	Sandstone-Brown			
125	158	Sandstone-Grey			
158	160	Limestone-Grey			

7 CONTRACTOR'S OR LANDOWNER'S CERTIFICATION: This water well was (1) constructed, (2) reconstructed, or (3) plugged under my jurisdiction and was completed on (mo/day/year) ... 04/16/98 ... and this record is true to the best of my knowledge and belief. Kansas Water Well Contractor's License No. ... 182 ... This Water Well Record was completed on (mo/day/yr) 4-23-98 under the business name of STRADER DRILLING CO., INC. by (signature) Dale Skron