

KANSAS WELL SCHEDULE

Card 1

Both 65175
5-4-73

Record by Kleinschmidt Date: 3/1-73 Project: Top-KC State: Kan County: Leaw 52

Latitude: _____ Longitude: _____ Accuracy: _____ Owner's well no: _____

Location: SW SE NE no. sec. 22 T. 11 N., R. 2 E. Well number: 1121E22ADC

Owner: David Johnson name address Topg

Owner: DAVID JOHNSON Altitude: 900 Accuracy: 3

Driller: Brewer Drilling Date drilled: 11-29-70

Topography, well site: (D) Draw, (F) flood plain, (L) lowland, (R) rolling, (S) slope, (T) terrace, (U) upland. Spring; or depth of well: 138 feet. Accuracy: 3

Diameter: 6 1/2 inches. Depth cased: 118 feet. Spring, or Csg. type: St. 1/3 Finish: _____ Lift & power: _____

Pump setting: _____ Use of well: Domestic

Water level: 81.8 feet above lsd. Accuracy: 0.1 M. Date measured: 1-3-21-73 Water level records avail. _____

Description MP: Top casing 1' 0" above yard

Yield: 25 gpm. Accuracy: 25 R. Pumping period: _____ Specific capacity: _____

Pumpage and other data available: _____

Card 2

Coefficient trans: _____ Coefficient storage: _____ Coefficient perm.: _____

Aquifer, system or series: _____

Aquifer, units: _____

Aquifer, thickness: _____ Aquifer, length of well open to: _____ Aquifer, depth to top of: _____ Aquifer, origin: _____

Aquifer, lithology of: _____

Bedrock, system: _____ Bedrock, formation: _____ Bedrock, depth to: _____

Surficial material: _____ Log data avail: Drillers Log

Quality of water data available: _____ Temperature of water: _____ Date sampled: _____

Coefficient of leakage: _____

THE FOLLOWING DATA ARE USED ON THE NATIONAL WELL SCHEDULE

Ownership category: (C) County, (F) Federal Gov't., (M) City, (N) Corp. or Co., (P) Private, (S) State Agency, (W) Water Dist. P

Method drilled: (A) Air, (B) bored, (C) cable, (D) dug, (V) driven, (H) hyd. rotary, (J) jetted, (R) rev. rotary, (T) trenching, (S) spring. C




Physiographic province: _____ Section: _____

Drainage basin: _____ Subbasin: _____ Depth to basement: _____ source of data (basement) _____

Quadrangle: _____

Well no. 11-21E-22ADC

90.0
-2.2
82.8
-1.0
81.8

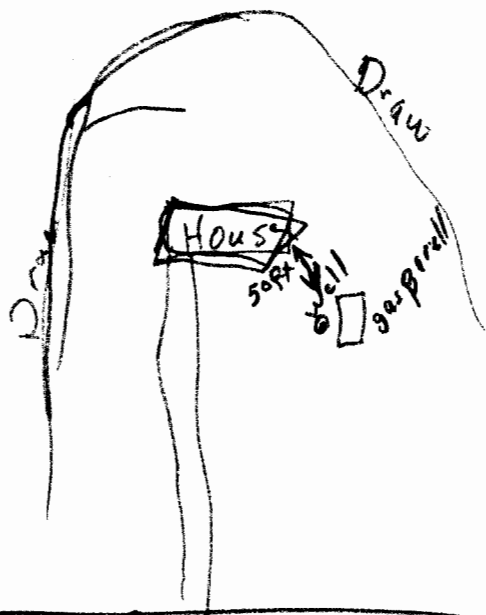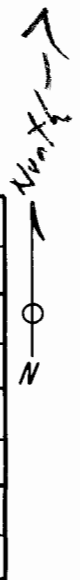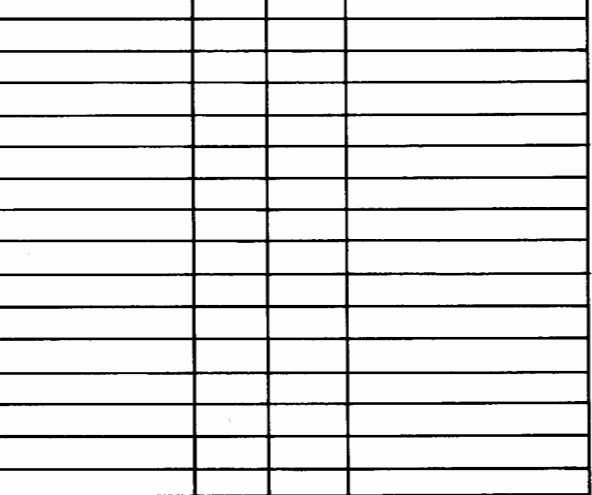

Co Road

Co Road

50x