

VBRT

WATER WELL RECORD

Not Home

DRILLERS LOG OF WELL

FROM (FT.)	TO (FT.)	KIND OF MATERIAL, COLOR, ETC. (NOTE WATER ZONES, AMOUNT, QUALITY)
0	1	Topsoil Fill
1	3	Top Soil
3	8	Clay
8	20	Broken rock and clay
20	39	Clay
39	41	Lime
41	70	Shale
70	105	Sandy shale
105	144	Shale
144	158	Sandstone— water
158	175	Lime
175	177	Shale T.D. 177 ft.

Well Owner Mr. Pete McMillon
 Address Winsock Lake
 Drilling Contractor Breuer Drilling Co.
Basehor, Kansas
 Date Drilled 3-1-67
 Method of Drilling Cable Tool
 (Cable tool, rotary, reverse rotary, etc.)
 Casing Schedule 177 ft. new 6" steel
 (Amount, Size, Setting—New, Used—Steel, Galv.—Gage or Weight)

Screen Data (if any): _____
 (Length, Diameter, Slot Size, Setting)


Measured depth to water on completed well (Static Level) is
100 ft. below land surface
 (Land Surface, Top of Casing, Etc.)

TESTED YIELD: 7 gallons per min.
 (Min., Hour)
 as determined by bailing
 (Bailing, Test Pumping, Etc.)

DRAWDOWN: _____ ft. after _____ hrs.
 pumping at _____ gal. per minute.


REMARKS:

TOP KAN

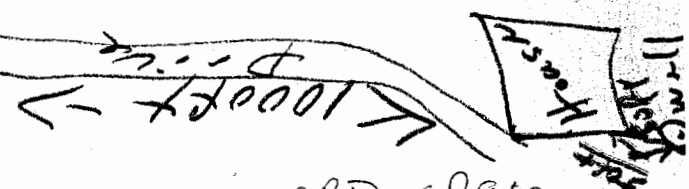

CBD EP 990

LOCATION OF WELL Topographic Sheet Tongi
 [Show location in Section Plat] Elev. 942

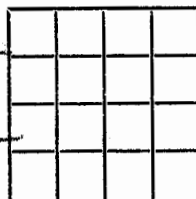

SW % Sec. 27
 T. 11 S., R. 21 E. W.
 County Raw

BR = 90 B

I = 84 B



KANSAS WELL SCHEDULE

Card 1

Record by Minodmint Date: 3-21-79 Project: Top-Kan State: Kan County: Leav 52

Latitude: _____ Longitude: _____ Accuracy: _____ Owner's well no: _____

Location: SW NWSW no. sec. 27, T. 11 N. R. 2B E. Well number: 1121E27CBC

Owner: Pete McMillon RRE 3 Wingsack Lake

Owner: PIETE McMILLON Altitude: 940 940 Accuracy 3

Driller: Breuer Drilling Basehor Ks Date drilled: 3-1-67

Topography, well site: (D) (F) (L) (R) (S) (T) (U) 4 Spring; or depth of well: 177 177 R 3

Diameter: 64 06 Depth cased: 177 177 Spring, or Csg. type: steel 5 Finish: _____ Lift & power: Sub-elec 0

Pump setting: _____ Use of well: Domestic, stock, irrigation, industrial, public supply, observation, none, test _____

Water level: 100 above lsd 100 R 3 Water level records avail. _____

Description MP: Approx 3' below lawn surface _____

Yield: 7 7 R 3 Pumping period: _____ Specific capacity: _____

Pumpage and other data available: _____

Card 2

Coefficient trans: _____ Coefficient storage: _____ Coefficient perm.: _____

Aquifer, system or series _____

Aquifer, units _____

Aquifer, thickness: _____ Aquifer, length of well open to: _____ Aquifer, depth to top of: _____ Aquifer, origin: _____

Aquifer, lithology of: _____

Bedrock, system: _____ Bedrock, formation: _____ Bedrock, depth to: _____

Surficial material: _____ Log data avail: Drillers Log A

Quality of water data available: Iron _____ Temperature of water: _____ Date sampled: _____

Coefficient of leakage _____

THE FOLLOWING DATA ARE USED ON THE NATIONAL WELL SCHEDULE Ownership category: _____ P

Method drilled: (A) (B) (C) (D) (V) (H) (J) (R) (T) (S) _____ C

Physiographic province: _____ Section: _____

Drainage basin: _____ Subbasin: _____ Depth to basement: _____ source of data (basement) _____

Quadrangle _____ Well no. 11-21E-27CBB

