

KANSAS WELL SCHEDULE

Card 1

Record by H. Schmidt Date: 3-16-73 Project: Top-Kc State: Kan K County: Leaw 52

Latitude: _____ Longitude: _____ Accuracy: _____ Owner's well no: _____

Location: SW SE SE no. sec. 28, T. 11 N., R. 21 E. Well number: 1121E28DDC

Owner: Tom John Smith (Paul McKee) KC, owner

Owner: TOM J SMITH Altitude 913 Accuracy 3

Driller: Brewer Drilling Bascher Date drilled: 10-25-72

Topography, well site: (D) Draw, (F) flood plain, (L) lowland, (R) rolling, (S) slope, (T) terrace, (U) upland S Spring; or depth of well: 137 137 3

Diameter: 6 inches or feet 06 Depth cased: 137 137 Spring, or Csg. type: Plastic Finish: _____ Lift & power: sub-etc 0

Pump setting: _____ Use of well: Domestic Domestic, stock, irrigation, industrial, public supply, observation, none, test _____ 1

Water level: 87.0 above 870 feet below _____ date measured _____ Water level records avail. _____

Description MP: Top casing at ground level covered by bucket

Yield: 6 6 R 3 Pumping period: _____ Specific capacity: _____

Pumpage and other data available: _____

Card 2

Coefficient trans: _____ Coefficient storage: _____ Coefficient perm.: _____

Aquifer, system or series _____

Aquifer, units _____

Aquifer, thickness: _____ Aquifer, length of well open to: _____ Aquifer, depth to top of: _____ Aquifer, origin: _____

Aquifer, lithology of: _____

Bedrock, system: _____ Bedrock, formation: _____ Bedrock, depth to: _____

Surficial material: _____ Log data avail: Drillers log _____

Quality of water data available: _____ Temperature of water: _____ Date sampled: _____



THE FOLLOWING DATA ARE USED ON THE NATIONAL WELL SCHEDULE
Ownership category: (C) County, (F) Federal Gov't., (M) City, (N) Corp. or Co., (P) Private, (S) State Agency, (W) Water Dist. _____ P

Method drilled: (A) Air, (B) bored, (C) cable, (D) dug, (V) driven, (H) hyd. rotary, (J) jetted, (R) rev. rotary, (T) trenching, (S) spring, _____ C

Physiographic province: _____ Section: _____

Drainage basin: _____ Subbasin: _____ Depth to basement: _____ source of data (basement) _____

Quadrangle _____
Well no. 11-21E-28 ddc

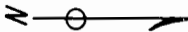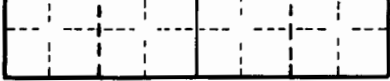

Co Road

Home

soft well



Garage

Grass

Drive

Bar

