

Record by Meiselsmith Date: 3-22-77 Project: top KC State: Kan County: Leaw 52
 2 3

Latitude: _____ Longitude: _____ Accuracy: _____ Owner's well no: _____

Location: SE SWNE no. sec. 11 T. 11 N. R. 2 E. Well number: 11 21 E 11 A C D
 4 5 6 7 8 9 10 11 12 13 14
 T R E-W sec no.

Owner: Glenn Martin Tongexoxie RPA 3
 name address

Owner: G L E N N M A R T I N Altitude: 925 925 Accuracy 3
 15 16 17 18 19 20 21 22 23 24 25 26 27 28 29 30 31 32 33 34 35 36 37 38 lsd 39 40 41 42 43 accuracy 44

Driller: Bruce Prilling Berahan Date drilled: 4-19-67
 name address

Topography, well site: (D) Draw, (F) flood plain, (L) lowland, (R) rolling, (S) slope, (T) terrace, (U) upland Spring; or depth of well: 120 120 R 3
 45 lsd feet 46 47 48 49 accuracy 50

Diameter: 6 1/2 06 Depth cased: 88 88 Spring, or Csg. type: steel S Finish: _____ Lift & power: _____
 inch. feet 51 52 feet 53 54 55 56 57 58

Pump setting: _____ Use of well: Domestic, stock, irrigation, industrial, public supply, observation, none, test _____
 lsd feet 59 60 61 62

Water level: 80 above lsd 80 R 3 Water level records avail. _____
 feet below 63 64 65 accuracy 66 67 68 69 mon year 70

Description MP: Top Casing 3' under water below sealed _____ lsd below

Yield: 15 15 R 3 Pumping period: _____ Specific capacity: _____
 gpm 71 72 73 74 accuracy 75 hours or days 76 77 gpm/ft. dd 78 79

Pumpage and other data available: _____ 80

Coefficient trans: _____ Coefficient storage: _____ Coefficient perm.: _____ gpd/ft. 15 16 17 18 19 20

Aquifer, system or series _____ 21 _____ 22 _____ 23 _____ 24

Aquifer, units _____ 25 26 27 _____ 28 29 30 _____ 31 32 33

Aquifer, thickness: _____ Aquifer, length of well open to: _____ Aquifer, depth to top of: _____ Aquifer, origin: _____
 feet 34 35 36 feet 37 38 39 feet 40 41 42 feet 43 44 45

Aquifer, lithology of: _____ 55 56

Bedrock, system: _____ Bedrock, formation: _____ Bedrock, depth to: _____ feet 57 58 59 60 lsd feet 61 62 63

Surficial material: _____ Log data avail: Drillers Log A
 lithology infiltration characteristics 64

Quality of water data available: _____ Temperature of water: _____ °F. _____ Date sampled: _____
 65 66 67 68 69 70

Coefficient of leakage _____




THE FOLLOWING DATA ARE USED ON THE NATIONAL WELL SCHEDULE

Ownership category: (C) County, (F) Federal Gov't., (M) City, (N) Corp. or Co., (P) Private, (S) State Agency, (W) Water Dist. _____ P
 71

Method drilled: (A) Air, (B) bored, (C) cable, (D) dug, (V) driven, (H) hyd. rotary, (J) jetted, (R) rev. rotary, (T) trenching, (S) spring, _____ C
 72

Physiographic province: _____ Section: _____
 73 74

Drainage basin: _____ Subbasin: _____ Depth to basement: _____ source of data (basement) _____
 75 76 77 78 79 80

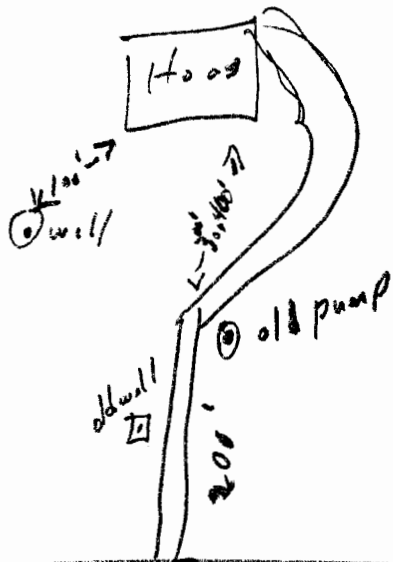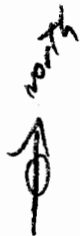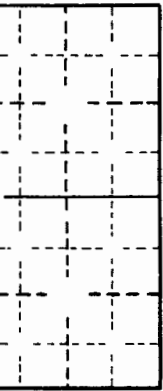

Co Road