

VBRT

2323 Ref 67 51

WATER WELL RECORD

DRILLERS LOG OF WELL

FROM (FT.)	TO (FT.)	KIND OF MATERIAL, COLOR, ETC. (NOTE WATER ZONES, AMOUNT, QUALITY)
0	2	Top Soil
2	25	Clay
25	55	Sandy Clay
55	77	Sandstone Gray
77	78	Slate
T. D. 78ft.		

Well Owner Mr. Larry Meadows

Address Tonganoxie, Kansas

Drilling Contractor Breuer Drilling Co
Basehor, Kansas

Date Drilled 9/18/72

Method of Drilling Cable Tools
 (Cable tool, rotary, reverse rotary, etc.)

Casing Schedule 80 ft. 62 Plastic
 (Amount, Size, Setting—New, Used—Steel, Galv.—Gage or Weight)

Screen Data (if any): _____
 (Length, Diameter, Slot Size, Setting)


Measured depth to water on completed well (Static Level) is
40 ft. below Land Surface
 (Land Surface, Top of Casing, Etc.)

TESTED YIELD: 15 gallons per Min
 (Min., Hour)

as determined by Bailing
 (Bailing, Test Pumping, Etc.)


DRAWDOWN: _____ ft. after _____ hrs.
 pumping at _____ gal. per minute.

REMARKS: TOP HAN

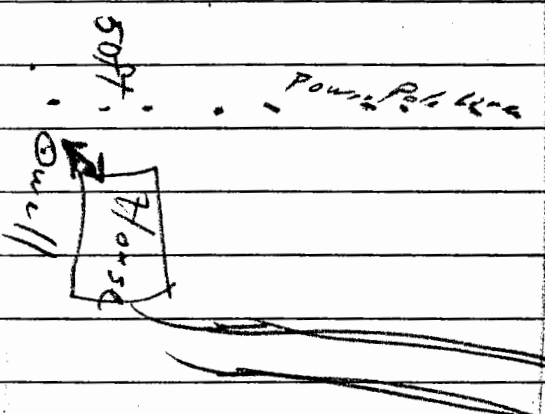

Co Road

LOCATION OF WELL Topographic Sheet Tongi
 [Show location in Section Plat] Elev. 866 ±

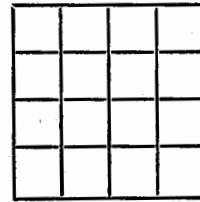

NE SE \times SE \times Sec. 11

T. 11 S., R. 21 E. W.

County Raw

BR=811

8=826

Record by Plumhardt Date: 3-21-73 Project: Top-KC State: Kans K County: Leav 52
2 3

Latitude: _____ Longitude: _____ Accuracy: _____ Owner's well no: _____
deg min sec deg min sec

Location: NE SE SE no. sec. 11 T. 11 N., R. 21 E. Well number: 1121E11DDA
W. T. R. E-W sec. 1 2 3 4 5 6 7 8 9 10 11 12 13 14 15 16 17 18 19 20 21 22 23 24 25 26 27 28 29 30 31 32 33 34 35 36 37 38 39 40 41 42 43 44 45 46 47 48 49 50

Owner: Larry Meadows name Tongonoxil address

Owner: LARRY MEADOWS 15 16 17 18 19 20 21 22 23 24 25 26 27 28 29 30 31 32 33 34 35 36 37 38 Altitude: 866 866 Accuracy 3
15 16 17 18 19 20 21 22 23 24 25 26 27 28 29 30 31 32 33 34 35 36 37 38 lsd 39 40 41 42 43 44

Driller: Breuer Drilling name Basehor Ks address Date drilled: 9-18-72

Topography, well site: (D) Draw, (F) flood plain, (L) lowland, (R) rolling, (S) slope, (T) terrace, (U) upland U Spring; or depth of well: 78 ft 45 lsd feet 46 47 48 49 accuracy 50

Diameter: 6" inches 06 51 52 Depth cased: 78 feet 78 53 54 55 Spring, or Csg. type: Plastic 56 Finish: _____ Lift & power: Sub-elec 57 58

Pump setting: _____ lsd feet 59 60 61 Use of well: Domestic, stock, irrigation, industrial, public supply, observation, none, test 62

Water level: 41.2 above lsd 41.2 M 1 3-21-73 C73 Water level records avail. _____ 63 64 65 accuracy 66 date measured 67 68 69 mon year 70

Description MP: Top casing lift above _____ above lsd _____

Yield: 15 gpm 15 R 3 Pumping period: _____ hours or days _____ Specific capacity: _____ gpm/ft. dd _____ 71 72 73 74 accuracy 75 76 77 78 79

Pumpage and other data available: _____ 80

Card 2

Coefficient trans: _____ gpd/ft _____ Coefficient storage: _____ Coefficient perm.: _____ gpd/ft².
15 16 17 18 19 20

Aquifer, system or series _____ 21 _____ 22 _____ 23 _____ 24

Aquifer, units _____ 25 26 27 _____ 28 29 30 _____ 31 32 33

Aquifer, thickness: _____ feet _____ 34 35 36 _____ 37 38 39 _____ 40 41 42 _____ 43 44 45

Aquifer, length of well open to: _____ feet _____ 46 47 48 _____ 49 50 51 Aquifer, depth to top of: _____ lsd feet _____ 52 53 54 Aquifer, origin: _____

Aquifer, lithology of: _____ 55 56

Bedrock, system: _____ 57 Bedrock, formation: _____ Bedrock, depth to: _____ lsd feet _____ 61 62 63

Surficial material: _____ lithology _____ infiltration characteristics _____ Log data avail: Drillers Log _____ 64

Quality of water data available: _____ Temperature of water: _____ °F. _____ Date sampled: _____ 65 66 67 68 69 70

THE FOLLOWING DATA ARE USED ON THE NATIONAL WELL SCHEDULE:

Ownership category: (C) County, (F) Federal Gov't., (M) City, (N) Corp. or Co., (P) Private, (S) State Agency, (W) Water Dist. P
71

Method drilled: (A) Air, (B) bored, (C) cable, (D) dug, (V) driven, (H) hyd. rotary, (J) jetted, (R) rev. rotary, (T) trenching, (S) spring. C
72

Physiographic province: _____ Section: _____ 73 74

Drainage basin: _____ Subbasin: _____ Depth to basement: _____ source of data (basement) _____ 75 76 77 78 79 80

Quadrangle _____

Well no. 11-21E-11 d d A

50.0
42.2
41.2

