USE TYPEWRITER OR BALL POINT PEN-PRESS FIRMLY, PRINT CLEARLY.

115

R

WATER WELL RECORD
KSA 82a-1201-1215

Kansas Department of Health and Environment-Division of Environment
(Water well Contractors)
Topeka, Kansas 66620

1. Location of well:	County	Fraction	Section number	Township number	Range number
	Leavenworth	SE ~~SW~~ 1/4 NE 1/4 SE 1/4	11	T 11 S	R 21 E/W

2. Distance and direction from nearest town or city: 1 mile east of Tonganoxie, Kansas
Street address of well location if in city:

3. Owner of well: Mr. John C. Suttridge
R.R. or street: Tonganoxie, Kansas
City, state, zip code: Jack Sturtridge ?

4. Locate with "X" in section below: Sketch map:

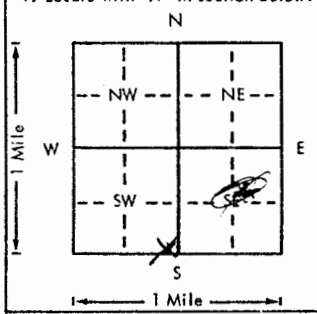

6. Bore hole dia. 8 in. Completion date 4-30-77
Well depth 100 ft.

7. __ Cable tool X Rotary __ Driven __ Dug
__ Hollow rod __ Jetted __ Bored __ Reverse rotary

8. Use: X Domestic __ Public supply __ Industry
__ Irrigation __ Air conditioning __ Stock
__ Lawn __ Oil field water __ Other

9. Casing: Material PL. Height: Above or below
Threaded ___ Welded X Surface ___ 18 in.
RMP ___ PVC X Weight ___ lbs./ft.
Dia. 5 in. to 101 ft. depth Wall Thickness: inches or
Dia. ___ in. to ___ ft. depth gage No. .265

5. Type and color of material	From	To
Top Soil	0	1
Sandy Clay - Yellow	1	36
Sandstone - Red	36	49
Sandstone - Gray	49	63
Lime - White	63	66
Slate - Black	66	71
Lime - White	71	75
Shale - Blue	75	95
Lime - White	95	100
(Use a second sheet if needed)		

10. Screen: Manufacturer's name (Slotted Pipe) Vinylplex, Inc.
Type PVC Dia. 5"
Slot/gauze .06 1/16 Length 13'
Set between 50 ft. and 63 ft.
___ ft. and ___ ft.
Gravel pack? X Size range of material 1/8 - 1/8

11. Static water level: mo./day/yr.
30 ft. below land surface Date 4-30-77

12. Pumping level below land surfaces:
___ ft. after ___ hrs. pumping ___ g.p.m.
___ ft. after ___ hrs. pumping ___ g.p.m.
Estimated maximum yield 20 g.p.m.

13. Water sample submitted: mo./day/yr.
___ Yes X No Date

14. Well head completion:
X Pitless adapter 18 Inches above grade

15. Well grouted? Yes
With: X Neat cement ___ Bentonite ___ Concrete
Depth: From 3 ft. to 15 ft.

16. Nearest source of possible contamination:
ft. 100' Direction east Type septic
Well disinfected upon completion? X Yes ___ No

17. Pump: ___ Not installed
Manufacturer's name Jacuzzi
Model number 5S4B HP 1/2 Volts 220
Length of drop pipe 95 ft. capacity 10 g.p.m.
Type:
X Submersible ___ Turbine
___ Jet ___ Reciprocating
___ Centrifugal ___ Other

T ___ R ___ E/W ___ Sec ___ 1/4 ___

18. Elevation: approx 840 msl
Topography: 1607
___ Hill
___ Slope
___ Upland
___ Valley

19. Remarks:

20. Water well contractor's certification:
This well was drilled under my jurisdiction and this report is true to the best of my knowledge and belief.
BREUER, INC. License No. 174
Business name
Address Box 147, Basehor, Ks. 66007
Signed [signature] Date 4-30-77
Authorized representative

Forward the white, blue and pink copies to the Department of Health and Environment

Form WWC-5

BR elev: 801'
V: 810

MI-1023