


1 LOCATION OF WATER WELL: Fraction **NW 1/4 NW 1/4 SW 1/4** Section Number **9** Township Number **T 11 S** Range Number **R 21** EW

Distance and direction from nearest town or city street address of well if located within city?  
**327 West Street, Tonganoxie, Kansas**

2 WATER WELL OWNER: **Ron Brummit** Board of Agriculture, Division of Water Resources  
 RR#, St. Address, Box # : **P.O. Box 705** Application Number:  
 City, State, ZIP Code : **Leavenworth, Kansas 66048**

3 LOCATE WELL'S LOCATION WITH AN "X" IN SECTION BOX:

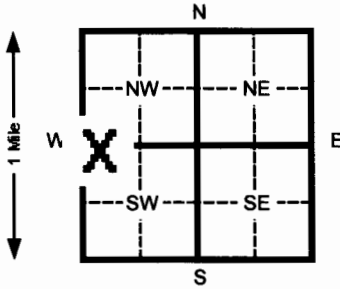

4 DEPTH OF COMPLETED WELL **10.0** ft. ELEVATION: \_\_\_\_\_

Depth(s) Groundwater Encountered 1 **6.0** ft. 2 \_\_\_\_\_ ft. 3 \_\_\_\_\_ ft.  
 WELL'S STATIC WATER LEVEL **5.29** ft. below land surface measured on mo/day/yr **07/26/07**  
 Pump test data: Well water was \_\_\_\_\_ ft. after \_\_\_\_\_ hours pumping \_\_\_\_\_ gpm  
 Est. Yield **NA** gpm: Well water was \_\_\_\_\_ ft. after \_\_\_\_\_ hours pumping \_\_\_\_\_ gpm  
 Bore Hole Diameter **8.5** in. to **10.0** in. ft. and \_\_\_\_\_ in. to \_\_\_\_\_ in. ft.  
 WELL WATER TO BE USED AS: 5 Public water supply 8 Air conditioning 11 Injection well  
 1 Domestic 3 Feed lot 6 Oil field water supply 9 Dewatering 12 Other (Specify below)  
 2 Irrigation 4 Industrial 7 Lawn and garden (domestic)  10 Monitoring well  
 Was a chemical/bacteriological sample submitted to Department? Yes \_\_\_\_\_ No  If yes, mo/day/yr sample was submitted  
 Water Well Disinfected? Yes \_\_\_\_\_ No

5 TYPE OF BLANK CASING USED: 5 Wrought Iron 8 Concrete tile CASING JOINTS: Glued \_\_\_\_\_ Clamped \_\_\_\_\_  
 1 Steel 3 RMP (SR) 6 Asbestos-Cement 9 Other (specify below) Welded \_\_\_\_\_  
 2 PVC 4 ABS 7 Fiberglass \_\_\_\_\_ Threaded   
 Blank casing diameter **2.375** in. to **4.0** ft., Dia \_\_\_\_\_ in. to \_\_\_\_\_ ft., Dia \_\_\_\_\_ in. to \_\_\_\_\_ ft.  
 Casing height above land surface **Flush Mount** in., weight \_\_\_\_\_ lbs./ft. Wall thickness or gauge No. **Schedule 40**

TYPE OF SCREEN OR PERFORATION MATERIAL:  7 PVC 10 Asbestos-cement  
 1 Steel 3 Stainless steel 5 Fiberglass 8 RMP (SR) 11 Other (specify) \_\_\_\_\_  
 2 Brass 4 Galvanized steel 6 Concrete tile 9 ABS 12 None used (open hole) \_\_\_\_\_  
 SCREEN OR PERFORATION OPENINGS ARE: 5 Gauzed wrapped 8 Saw cut 11 None (open hole)  
 1 Continuous slot  3 Mill slot 6 Wire wrapped 9 Drilled holes  
 2 Louvered shutter 4 Key punched 7 Torch cut 10 Other (specify) \_\_\_\_\_  
 SCREEN-PERFORATED INTERVALS: From **10.0** ft. to **4.0** ft. From \_\_\_\_\_ ft. to \_\_\_\_\_ ft.  
 From \_\_\_\_\_ ft. to \_\_\_\_\_ ft. From \_\_\_\_\_ ft. to \_\_\_\_\_ ft.  
 GRAVEL PACK INTERVALS: From **10.0** ft. to **3.0** ft. From \_\_\_\_\_ ft. to \_\_\_\_\_ ft.  
 From \_\_\_\_\_ ft. to \_\_\_\_\_ ft. From \_\_\_\_\_ ft. to \_\_\_\_\_ ft.

6 GROUT MATERIAL: 1 Neat cement  2 Cement grout  3 Bentonite 4 Other \_\_\_\_\_  
 Grout Intervals From **0.0** ft. to **1.5** ft. From **1.5** ft. to **3.0** ft. From \_\_\_\_\_ ft. to \_\_\_\_\_ ft.  
 What is the nearest source of possible contamination:  10 Livestock pens 14 Abandoned water well  
 1 Septic tank 4 Lateral lines 7 Pit privy  11 Fuel storage 15 Oil well/ Gas well  
 2 Sewer lines 5 Cess pool 8 Sewage lagoon 12 Fertilizer storage 16 Other (specify below) \_\_\_\_\_  
 3 Watertight sewer lines 6 Seepage pit 9 Feedyard 13 Insecticide storage  
 Direction from well? **Northwest** How many feet? **130**

FROM	TO	CODE	LITHOLOGIC LOG
0.0	6.0		Brown very silty clay, very firm-firm, slightly moist-moist
6.0	7.0		Brown very silty clay, firm, wet
7.0	8.5		Brown-light brown weathered shale, very slightly gravelly, very firm, moist-slightly moist
8.5	10.0		Brown shale, calcareous, limestone fragments and stringers, very hard, dry

**Flush-mount well completion waiver existent for site.**

7 CONTRACTOR'S OR LANDOWNER'S CERTIFICATION: This water well was  (1) constructed, (2) reconstructed, or (3) plugged under my jurisdiction and was completed on (mo/day/yr) **07/25/07** and this record is true to the best of my knowledge and belief. Kansas Water Well Contractor's License No. **692** This Water Well Record was completed on (mo/day/yr) **08/01/07** under the business name of **Quad State Services, Inc.** by (signature) *Ron Brummit*

OFFICE USE ONLY

T R

SEC

INSTRUCTIONS: Please fill in blanks and circle the correct answers. Send three copies to Kansas Department of Health and Environment, Bureau of Water, 1000 S W Jackson St., Ste. 420, Topeka, Kansas 66612-1367. Telephone: 913-296-5545. Send one to WATER WELL OWNER and retain one for your records.