


1 LOCATION OF WATER WELL: County: Leavenworth Fraction: N6 1/4 NW 1/4 SE 1/4 Section Number: 10 Township Number: 11 Range Number: 21 EW

Distance and direction from nearest town or city street address of well if located within city?
20871 Sandusky Rd. Leavenworth, Ks. 66084

2 WATER WELL OWNER: Rob Calovich Global Positioning Systems (decimal degrees, min. of 4 digits)
 RR#, St. Address, Box #: 20871 Sandusky Rd Latitude: _____
 City, State ZIP Code: Tonganoxie, Ks. 66084 Longitude: _____
 Elevation: _____
 Datum: _____
 Data Collection Method: _____

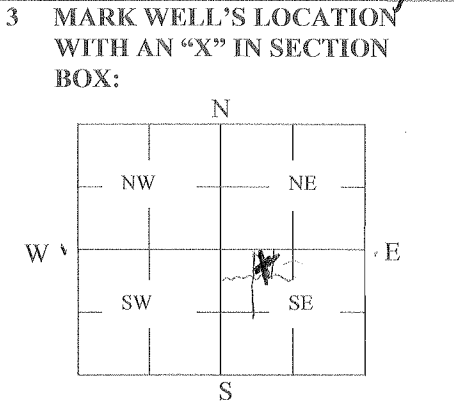

4 DEPTH OF WELL 100 ft.
 WELL'S STATIC WATER LEVEL 90 ft.
 WELL WAS USED AS:
 Domestic 5 Public Water Supply 9 Dewatering
 2 Irrigation 6 Oil Field Water Supply 10 Monitoring
 3 Feedlot 7 Domestic (Lawn & Garden) 11 Injection Well
 4 Industrial 8 Air Conditioning 12 Other _____
 Was a chemical/bacteriological sample submitted to Department? Yes _____ No

5 TYPE OF BLANK CASING USED:
 1 Steel 3 RMP (SR) 5 Wrought 7 Fiberglass 9 Other (Specify below)
 PVC 4 ABS 6 Asbestos-Cement 8 Concrete Tile
 Blank casing diameter 5 in. Was casing pulled? Yes _____ No If yes, how much _____
 Casing height above of below land surface 36 in. Cut off top 3' of casing

6 GROUT PLUG MATERIAL: 1 Neat cement 2 Cement grout Bentonite Other Sand
 Grout Plug Intervals: From 100 ft. to 50 ft., From 50 ft. to 20 ft., From 20 to 0 ft.
grout sand grout
 What is the nearest source of possible contamination:
 Septic tank 6 Seepage pit 11 Fuel Storage 16 Other (specify below) _____
 Sewer lines 7 Pit privy 12 Fertilizer storage _____
 Watertight sewer lines 8 Sewage lagoon 13 Insecticide storage _____
 Lateral lines 9 Feedyard 14 Abandoned water well Direction from well? North, West
 Cess pool 10 Livestock pens 15 Oil well/Gas well How many feet? 100'

FROM	TO	PLUGGING MATERIALS	FROM	TO	PLUGGING MATERIALS
100	50	Bentonite			
50	20	Childproofed sand			
20	0	Bentonite			

7 CONTRACTOR'S OR LANDOWNER'S CERTIFICATION: This water well was plugged under my jurisdiction and was completed on (mo/day/year) 3-31-14 and this record is true to the best of my knowledge and belief. Kansas Water Well Contractor's License No. 561. This Water Well Record was completed on (mo/day/year) 4-2-14 under the business name of Evans Energy Services by (signature) [Signature]